



T-2634

RECEIVED
APR 2 1972
STATE ENGINEER
SALEM, OREGON

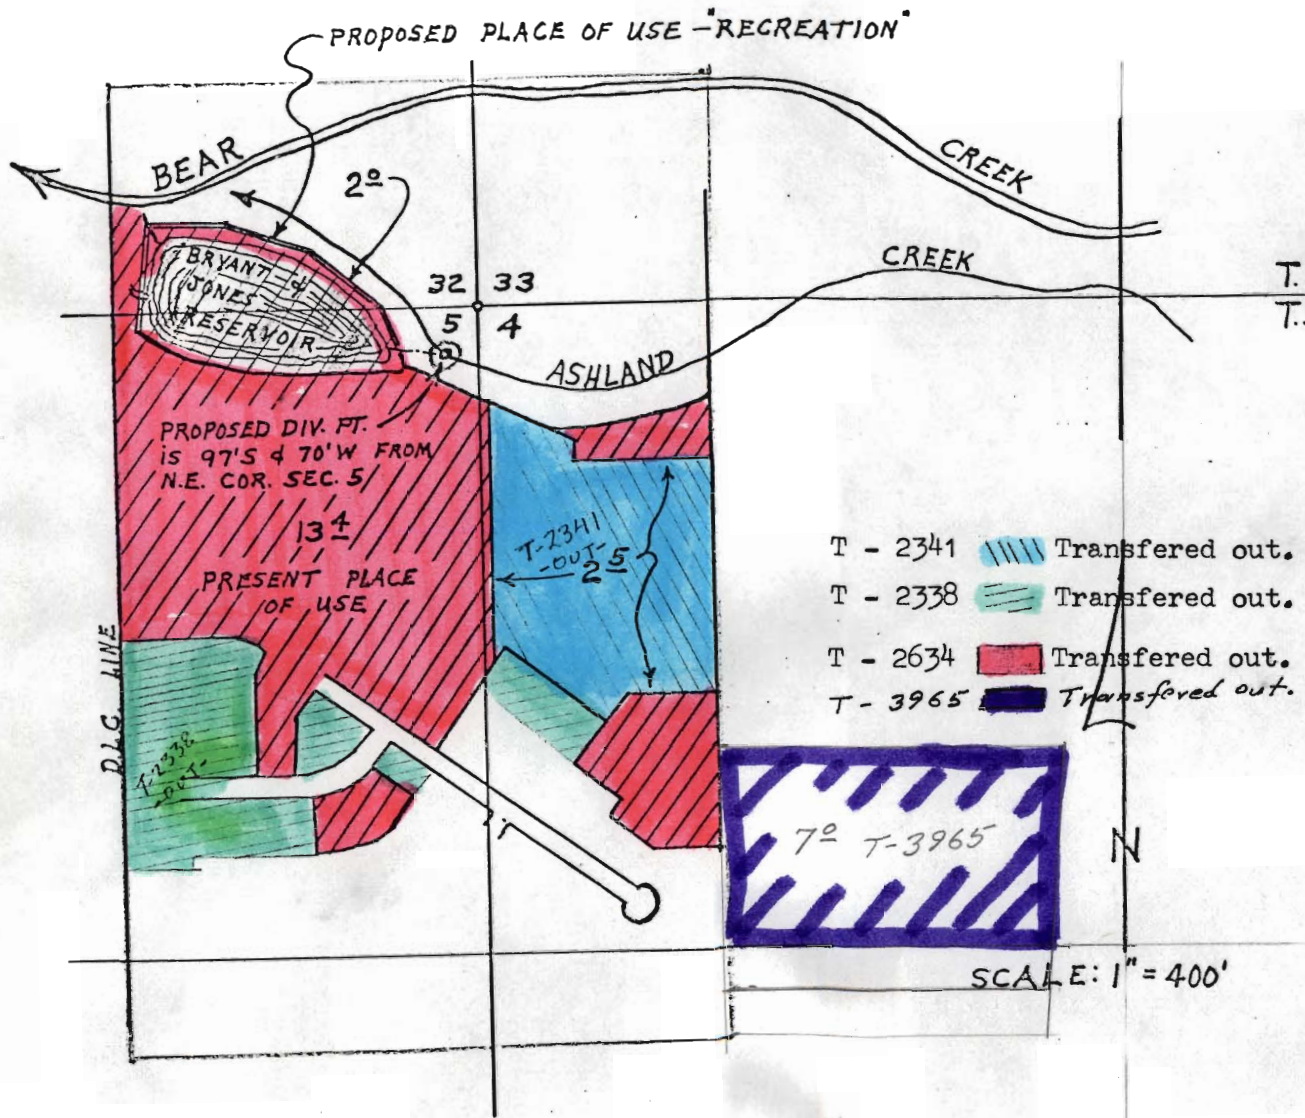

T.38S.R.1E.W.M. 8.72 33
T.39S.R.1E.W.M. 575' 4

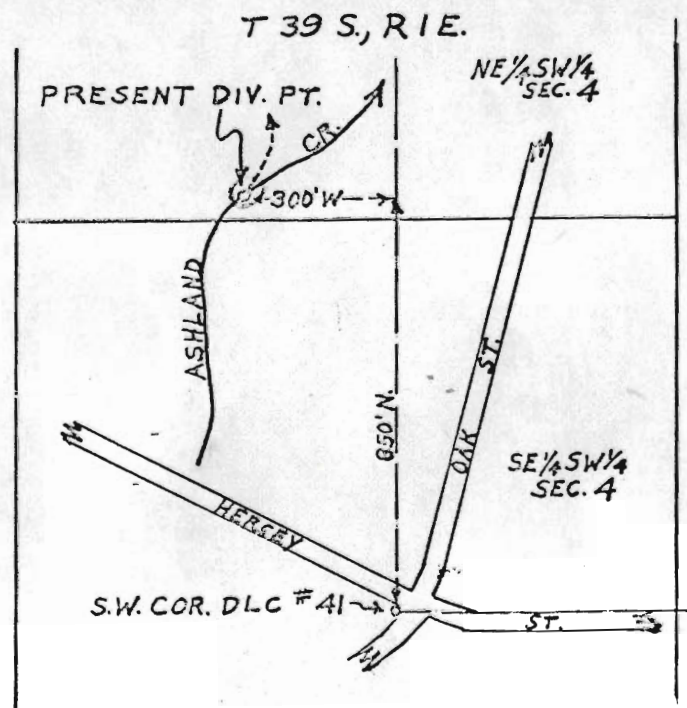

KENNETH H. JONES AND PHILLIP F. BRYANT
FOR CHANGE IN POINT OF DIVERSION, PLACE OF
USE AND CHARACTER OF USE.