


T. 38S., R. 8W., W.M.

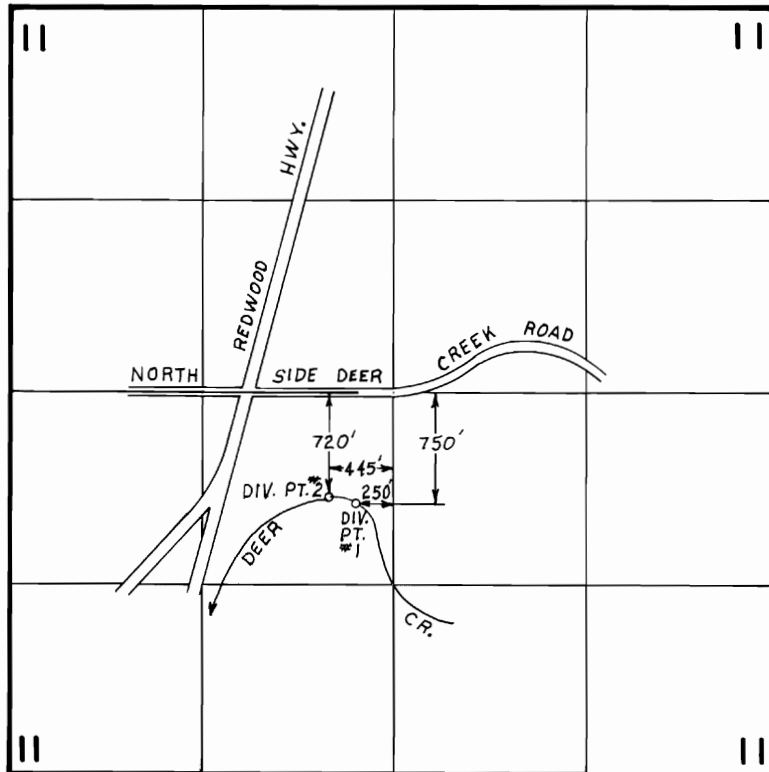

**FINAL PROOF SURVEY**  
UNDER

TRANSFER NO. 3976

Application No. .... Permit No. ....

IN NAME OF

**RAYMOND & EMMA PRICE & LELA L. PLUMLEE**

Surveyed OCT. 27, 1983, by B. S. JAMES

SCALE: 4" = 1 MILE