


RECEIVED

JUL 12 1981

WATER RESOURCES DEPT
OREGON

T.16S. R.11E. W.M.

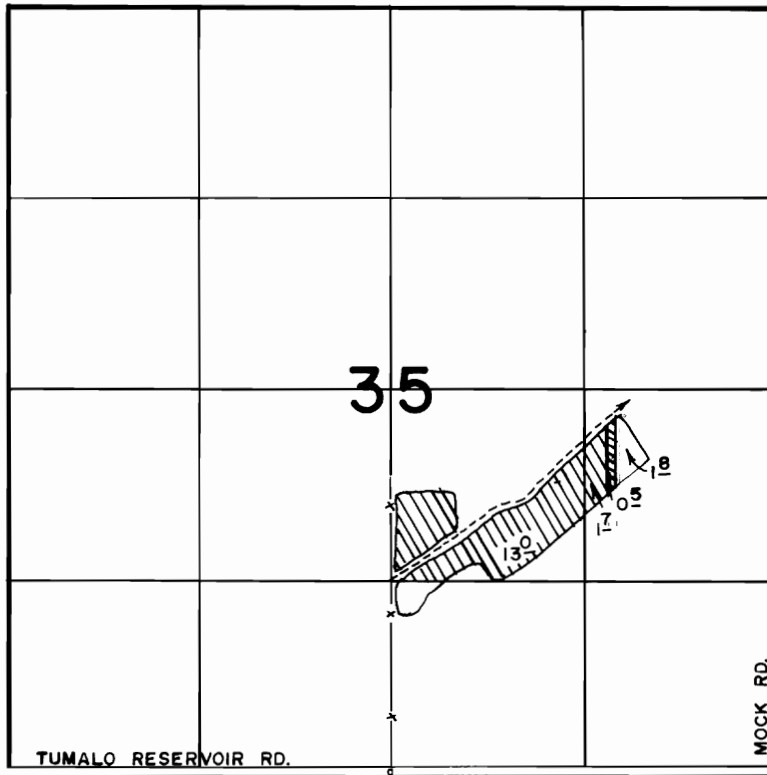

1907 PRIORITY

1900 PRIORITY

FINAL PROOF SURVEY

UNDER

PORTION OF TRANSFER 3989


Application No. Permit No.

IN NAME OF

...TUMALO IRRIGATION DISTRICT...

Surveyed JUL. 6. 1981., by L.H. NUNN.....

T.17S., R.12E., W.M.

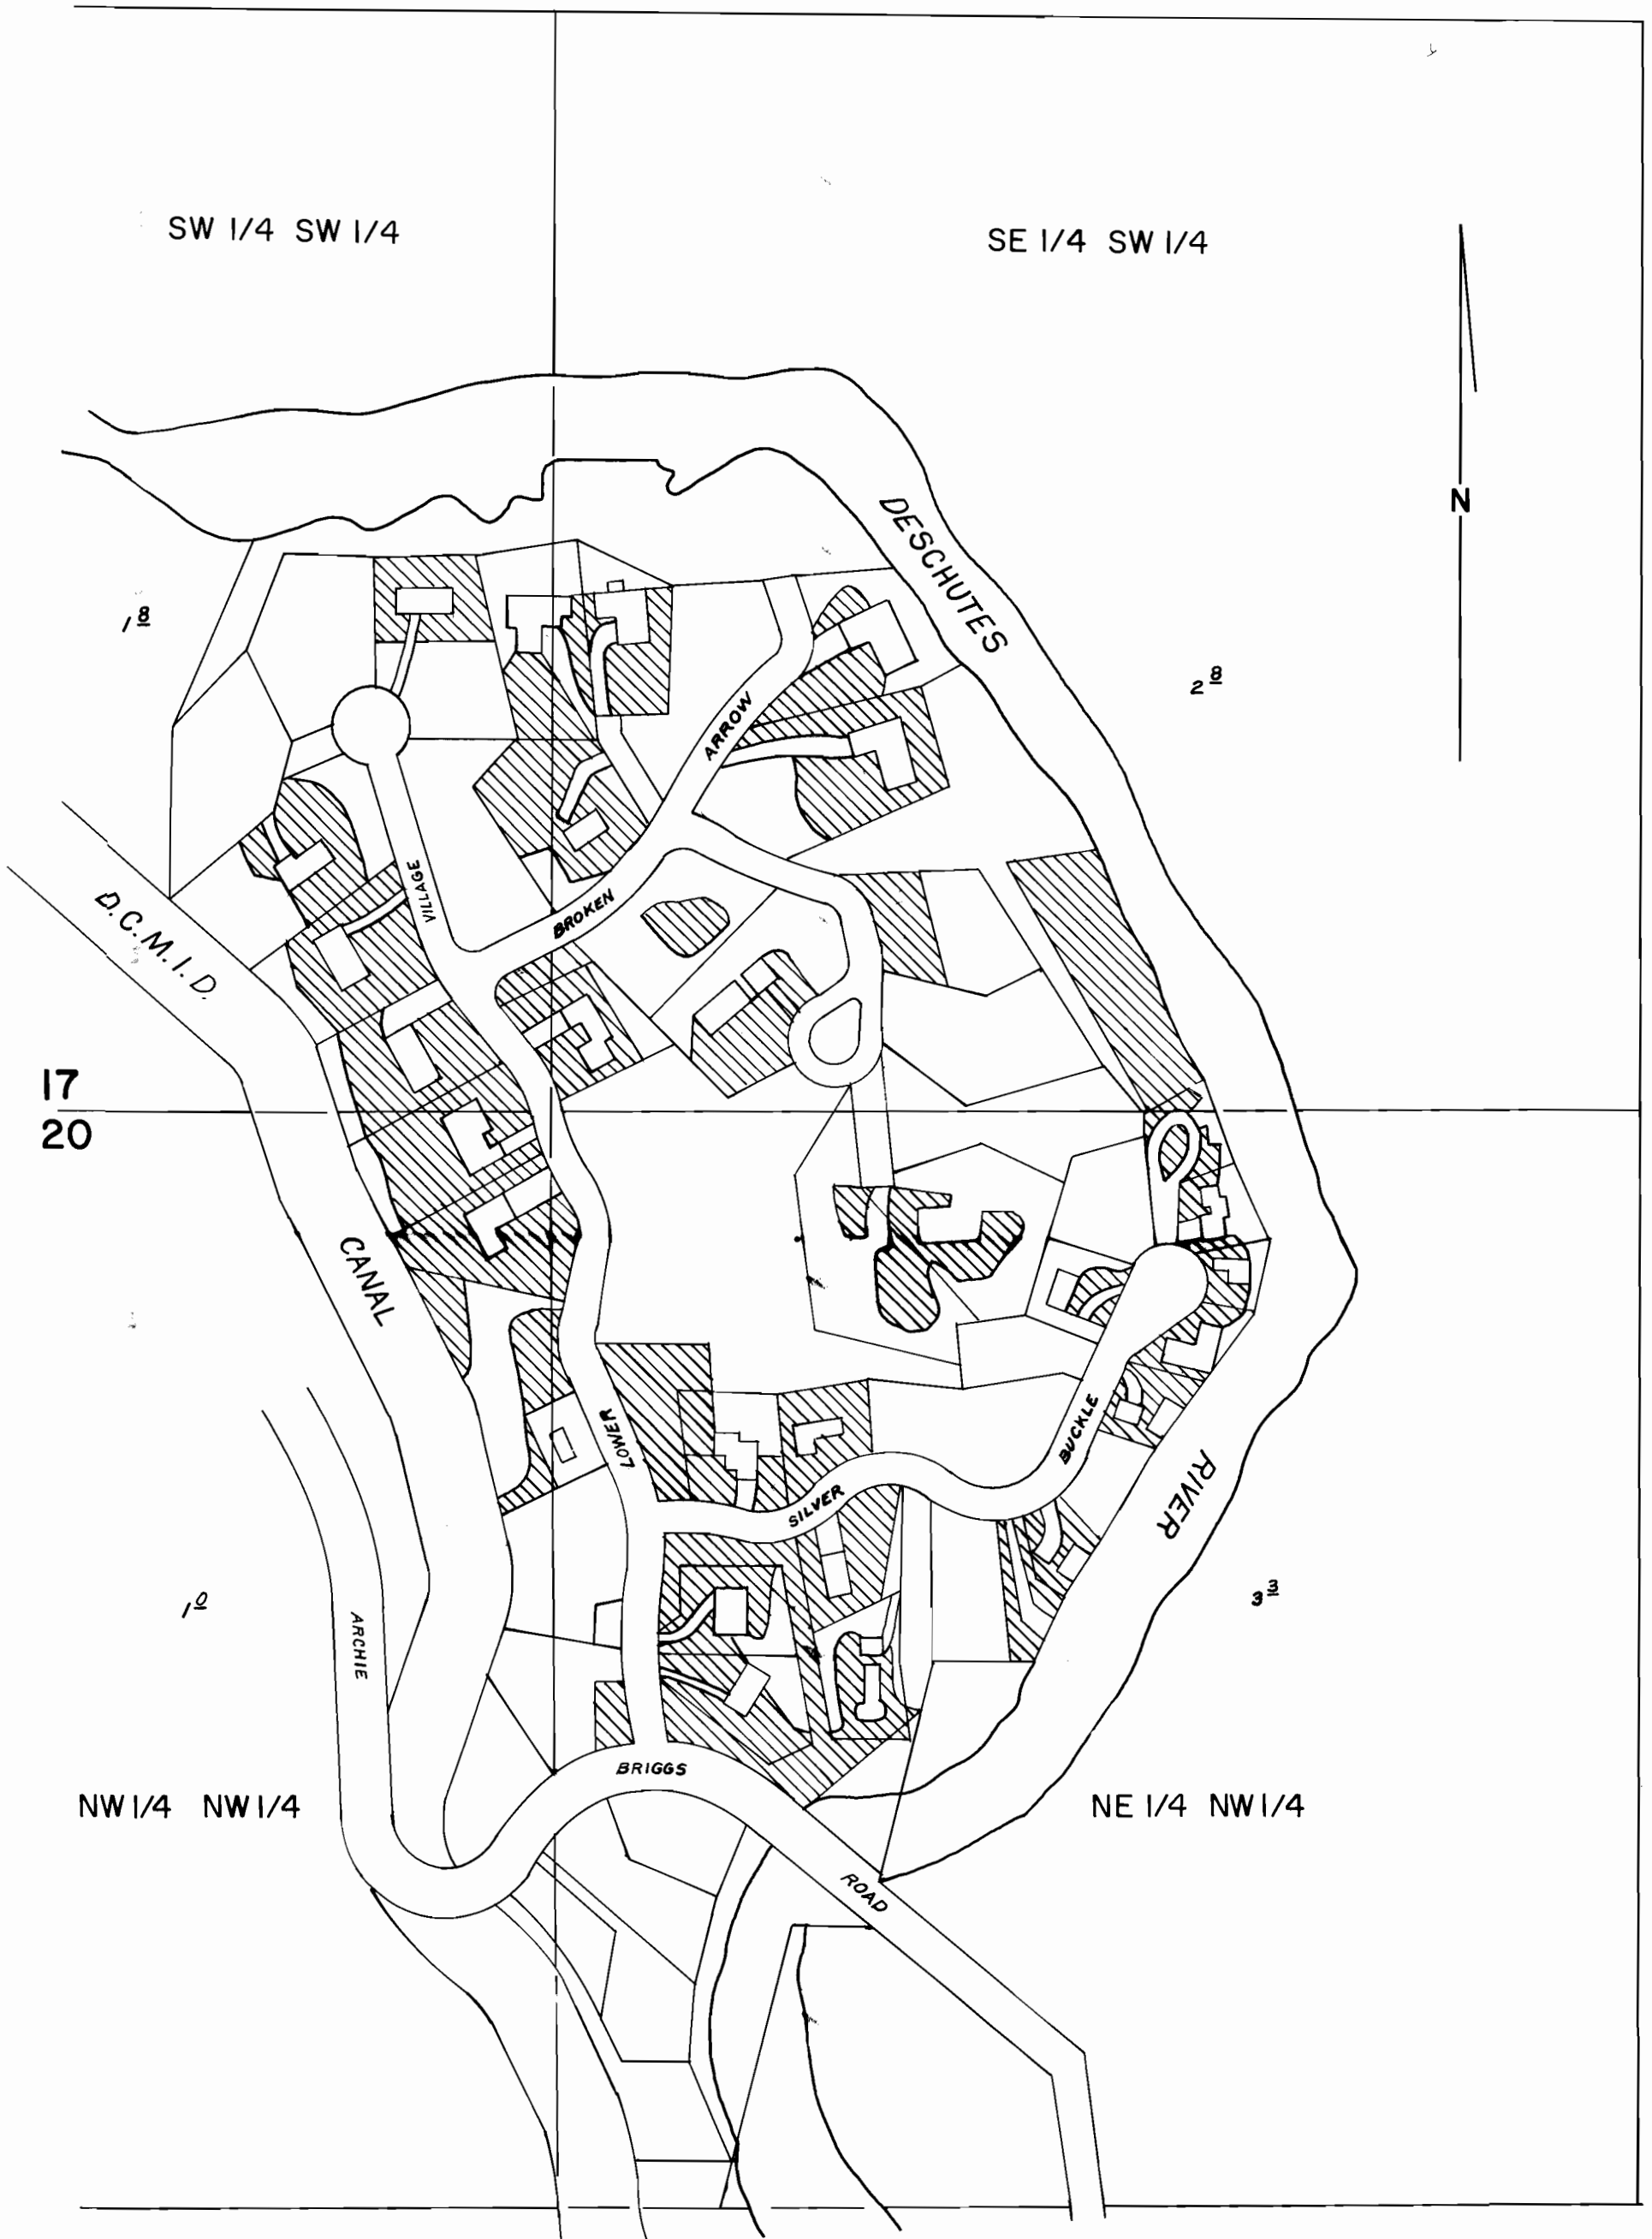

FINAL PROOF SURVEY
UNDER

SCALE: 1" = 200'

TRANSFER NO. 3989 & 3990

RIMROCK WEST SUBDIVISION

SURVEYED JUNE 6, 1985 by LESLIE OLSON