


T. 37 S., R. 5 W., W.M.

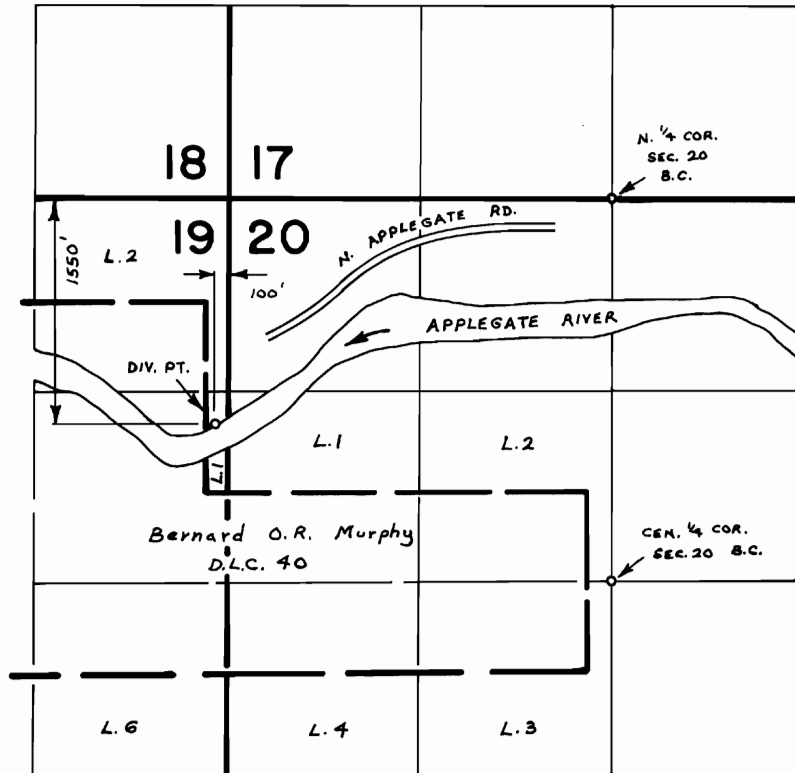

FINAL PROOF SURVEY UNDER

Transfer No. 4000

Application No. Permit No.
IN NAME OF

HAZEL THOMPSON

Surveyed MAR. 30 19.79, by B. SUND

D.H.M.

B50-1-3