


T.14S., R.13E., W.M.

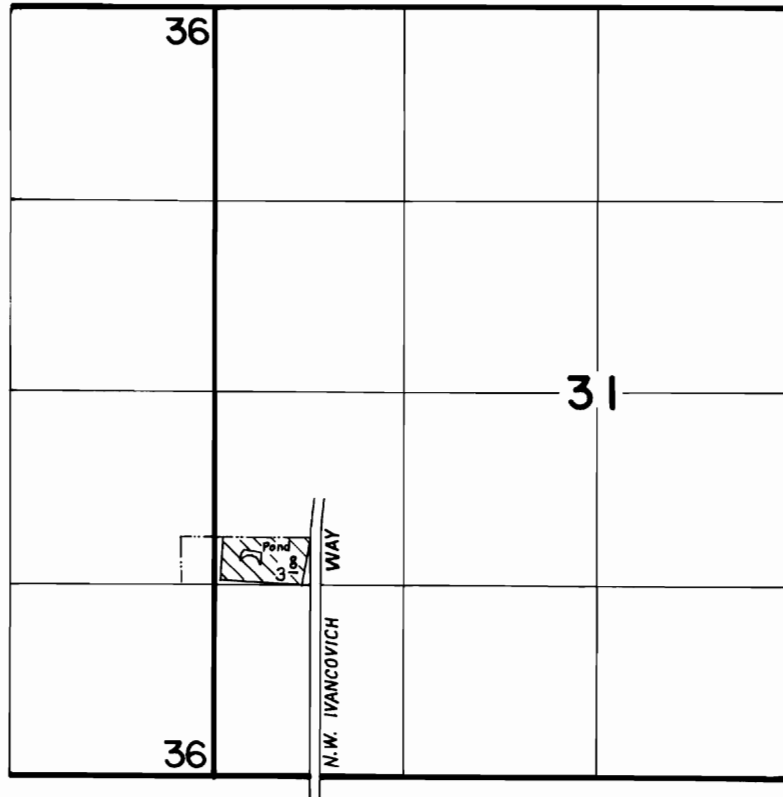

SCALE: 1" = 1320'

FINAL PROOF SURVEY UNDER

TRANSFER NO. 4006
Application No. Permit No.
IN NAME OF

...JAMES G. WIEDEN / C.O.I.D.

Surveyed AUG. 22, 1984, by LESLIE OLSON...