


T.18S., R.13E., W.M.

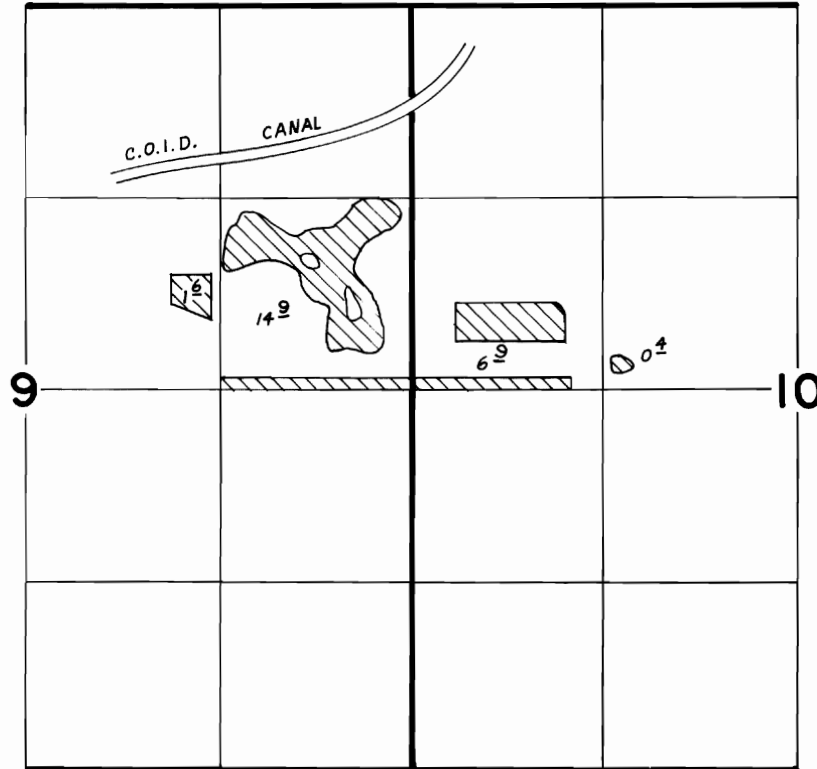

SCALE: 1" = 1320'

FINAL PROOF SURVEY

UNDER

TRANSFER NO. 4007

Application No. Permit No.

IN NAME OF

...**DELMAR KENNEL / C.O.I.D.**.....

Surveyed SEPT..19.. 19.84, by **LESLIE OLSON**...