


T. 35 S., R. 4 W., W. M.

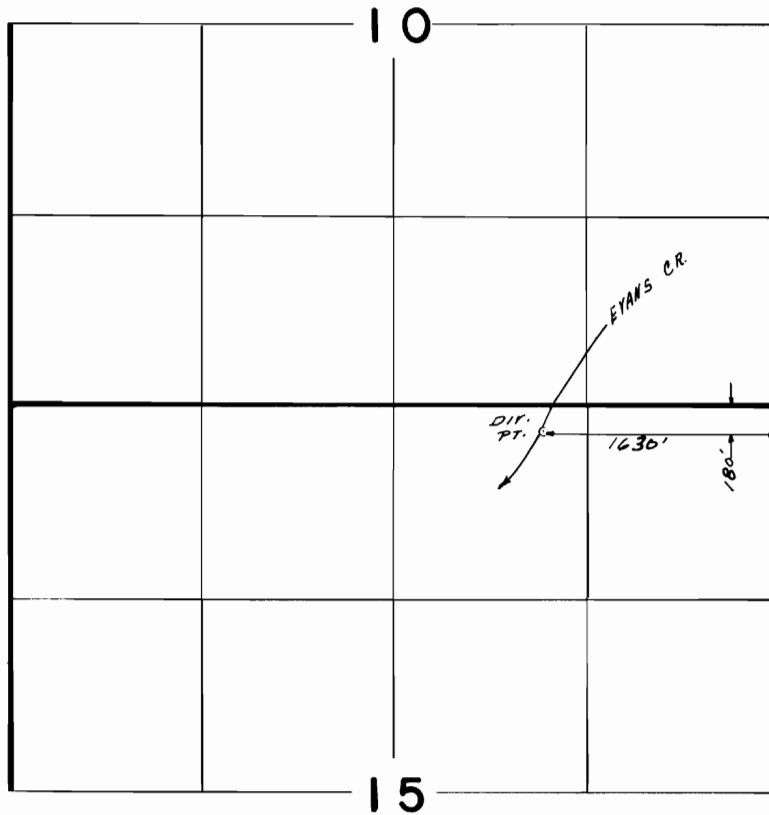

Scale: 1" = 1320'

**FINAL PROOF SURVEY**

UNDER

**TRANSFER NO. 4016**

Application No. .... Permit No. ....

IN NAME OF

**HAROLD & HAZEL WILSON**

Surveyed .F.E.B..11. 19.8.6, by .B...S...JAMES..