


T. 36 S., R. 1 W., W.M.

SEC. 3

SE 1/4 SW 1/4

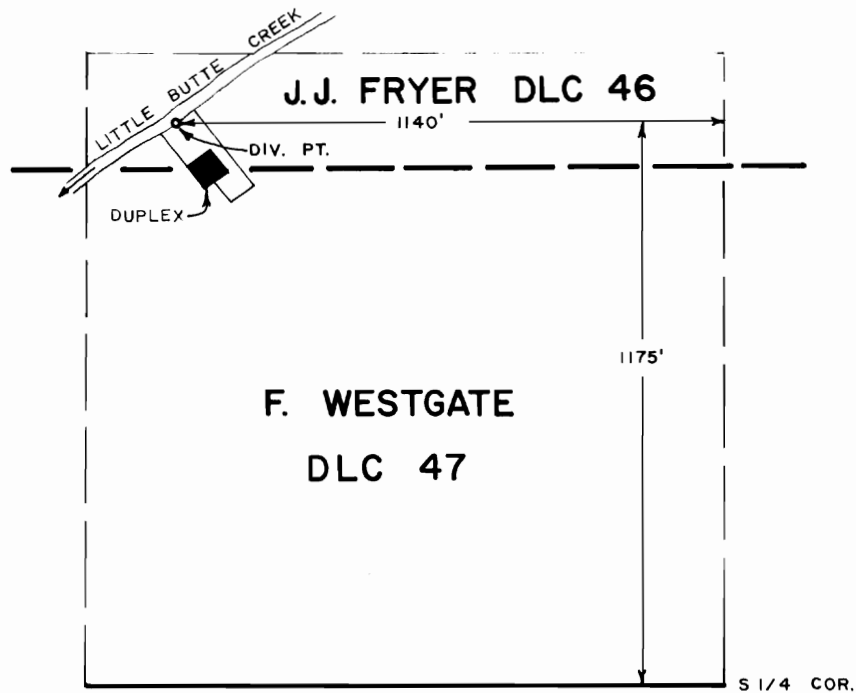

FINAL PROOF SURVEY

UNDER

TRANSFER NO. 4027

Application No. Permit No.

IN NAME OF

.....*Charles E. Kimmel*.....

Surveyed AUG. 29. 1983., by ..B. SUZIE JAMES

SCALE: 1" = 400'