


T.29S. R.5W. W.M.

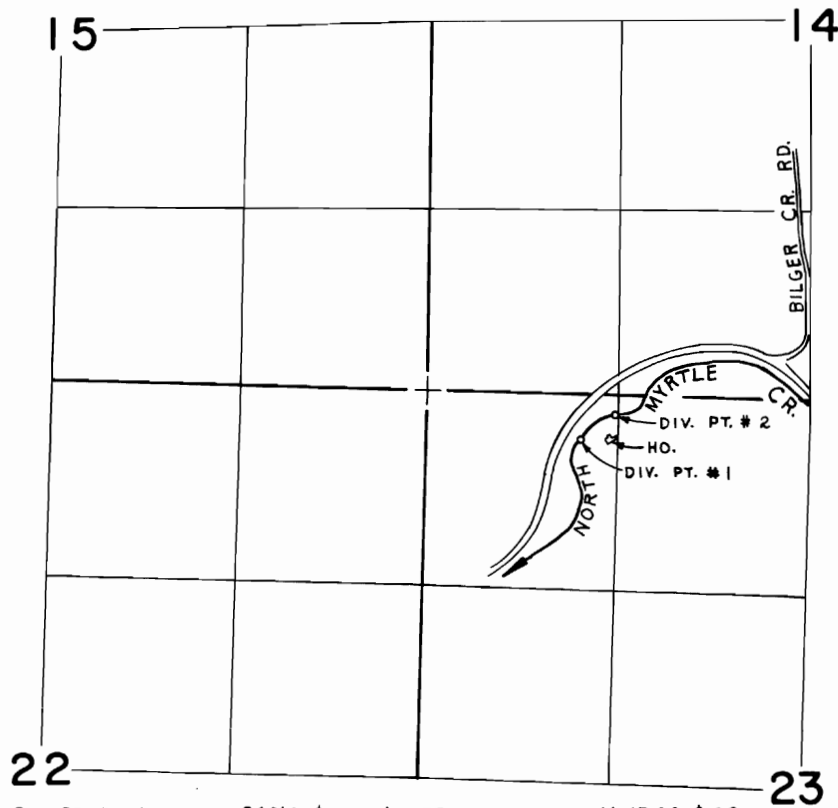

DIV. PT. # 1 LOCATED 340'S. & 1,050' E. FROM COR. SEC. 14, 15, 22, & 23
DIV. PT. # 2 LOCATED 160'S. & 1,290' E. FROM COR. SEC. 14, 15, 22, & 23

SCALE: 4" = 1 mile

FINAL PROOF SURVEY UNDER

Application No. Permit No. T. 4041....
IN NAME OF

TIMOTHY & ROBIN WATSON

Surveyed DEC. 20, 1983, by L. CASHION...