


T-4059

T. 29 S. R. 5 W. W.M.

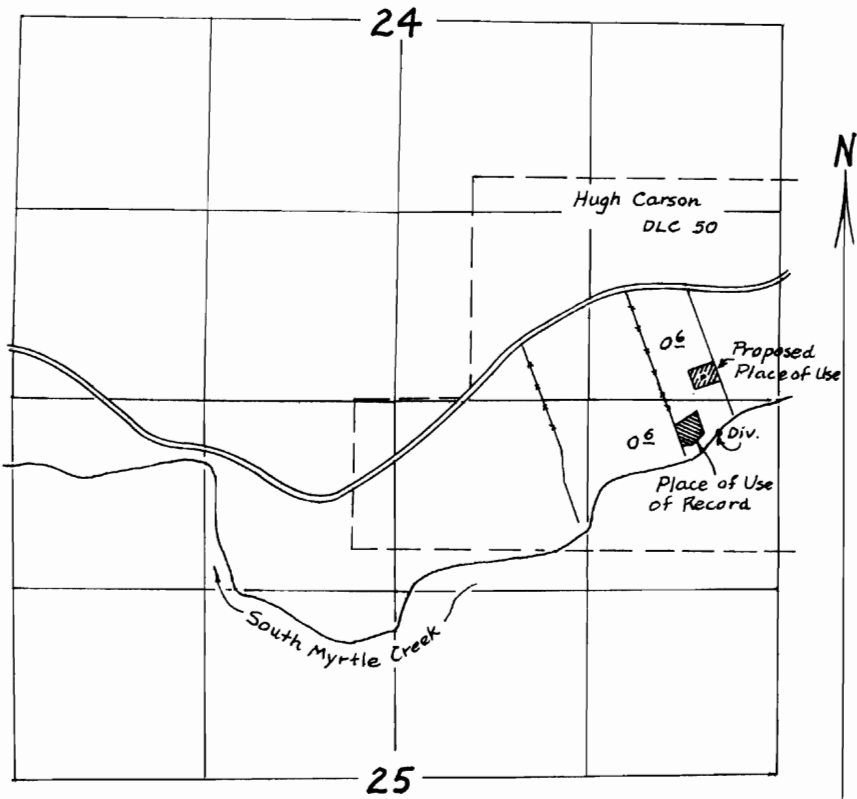

Scale: 4" = 1 mile.