




T.14&15S., R.11E., W.M.

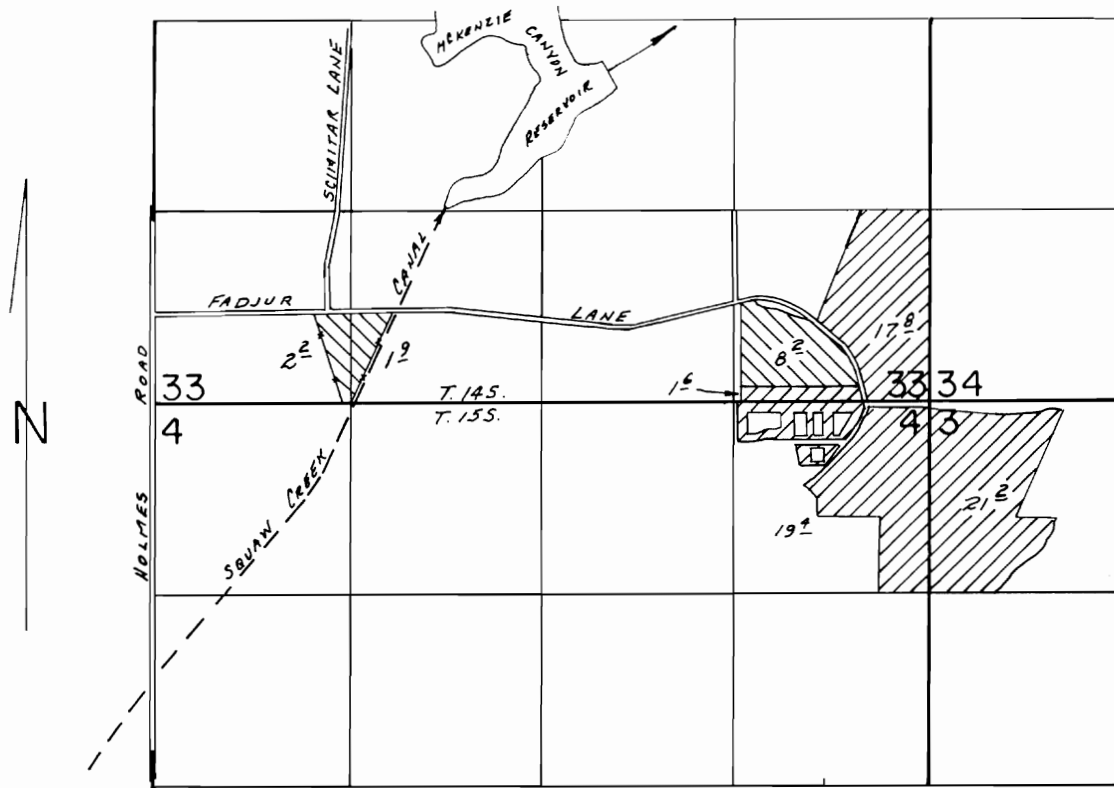

SCALE: 1" = 1320'

-  T-4074
-  T-5711

FINAL PROOF SURVEY
 UNDER

Transfer Nos. 4074 & 5711

IN NAME OF

ROBERT L. STEPHENSON & STEVE PALFY

Surveyed Aug. 24, 1987, by M. J. MATTICK