


T.17S.,R.14E.,W.M.

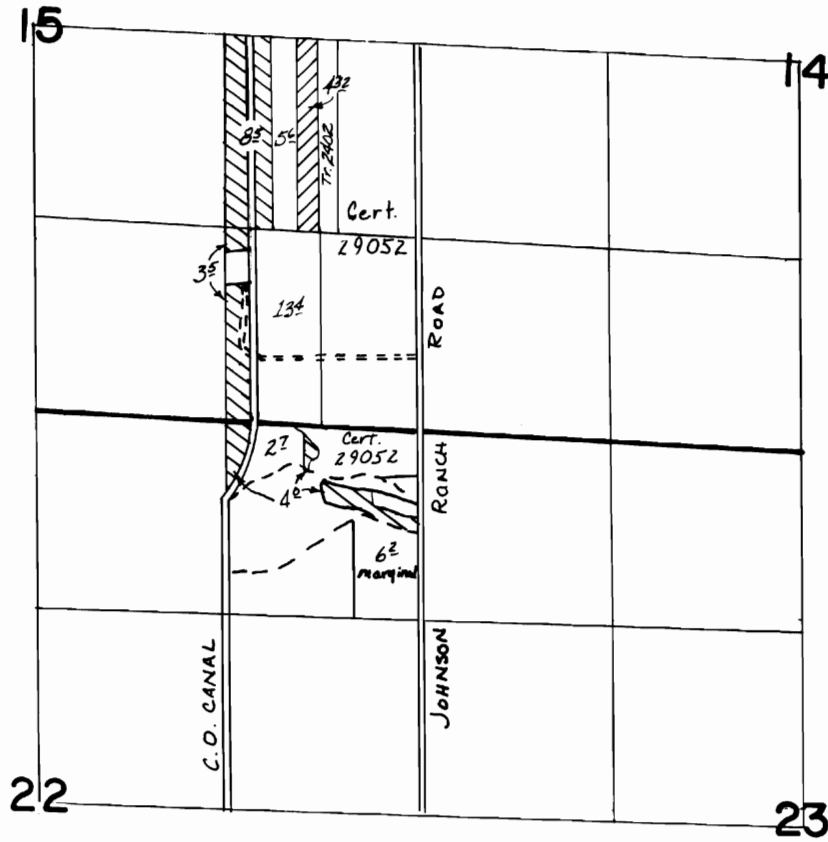

SCALE : 4"=1mile

**FINAL PROOF SURVEY**

UNDER

Transfers   4075 & 4077

Application No. .... Permit No. ....  
IN NAME OF

**JAMES JONES, HARPER BROWN**

Surveyed MAY 16, 1984, by L. OLSON

