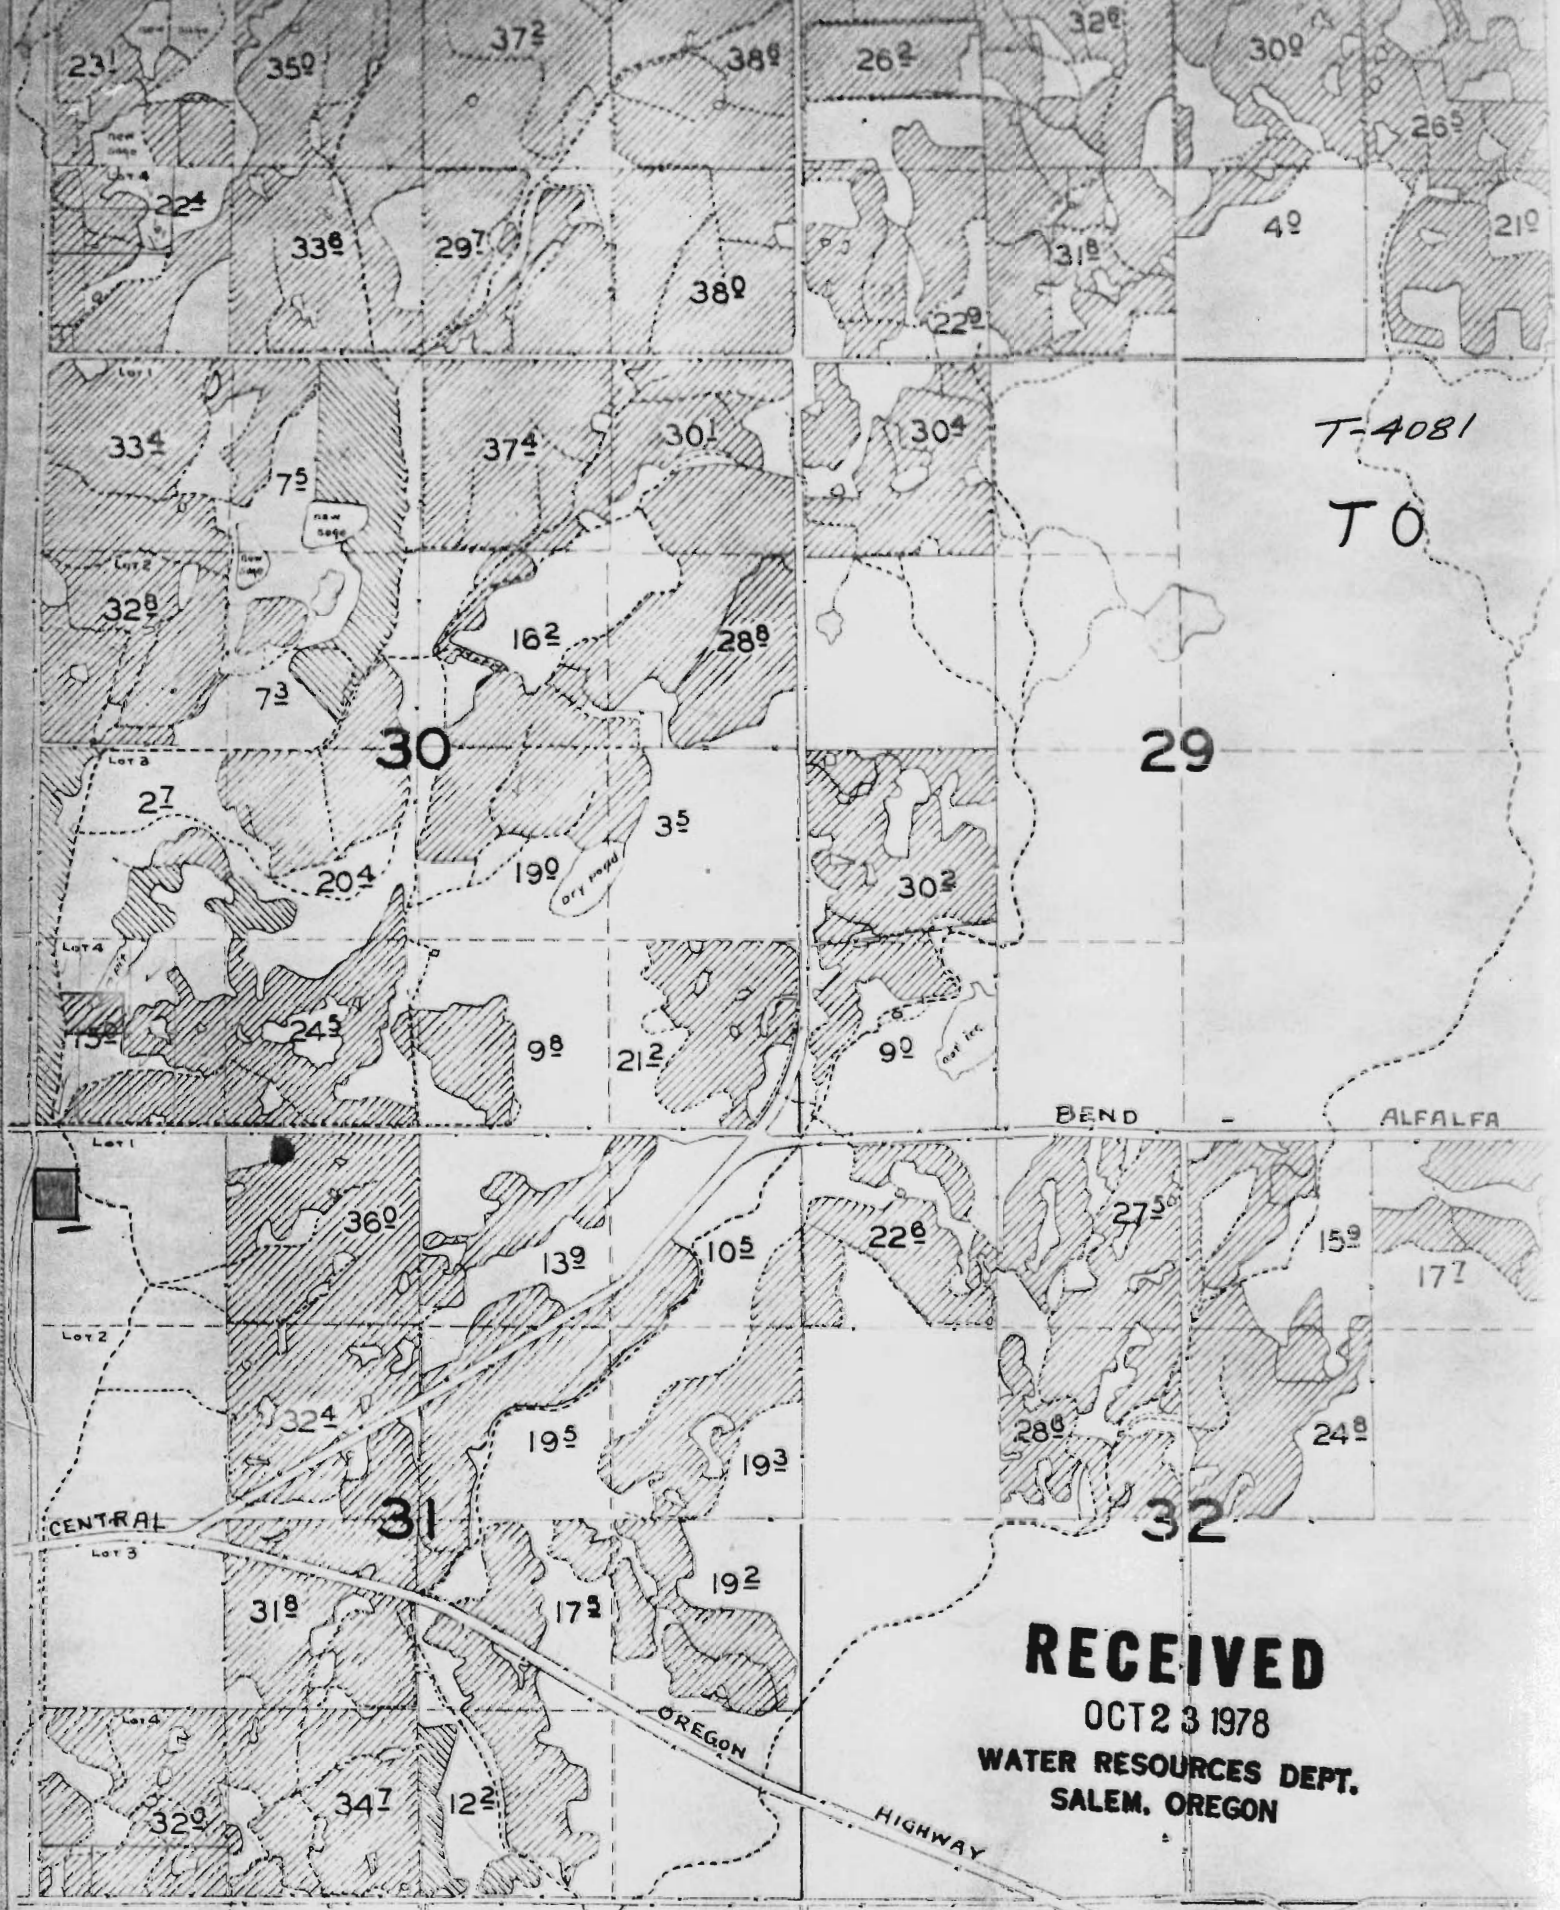
T-4081
T 0
30
29
31
32
BEND - ALFALFA
CENTRAL OREGON HIGHWAY
RECEIVED
OCT 23 1978
WATER RESOURCES DEPT.
SALEM, OREGON

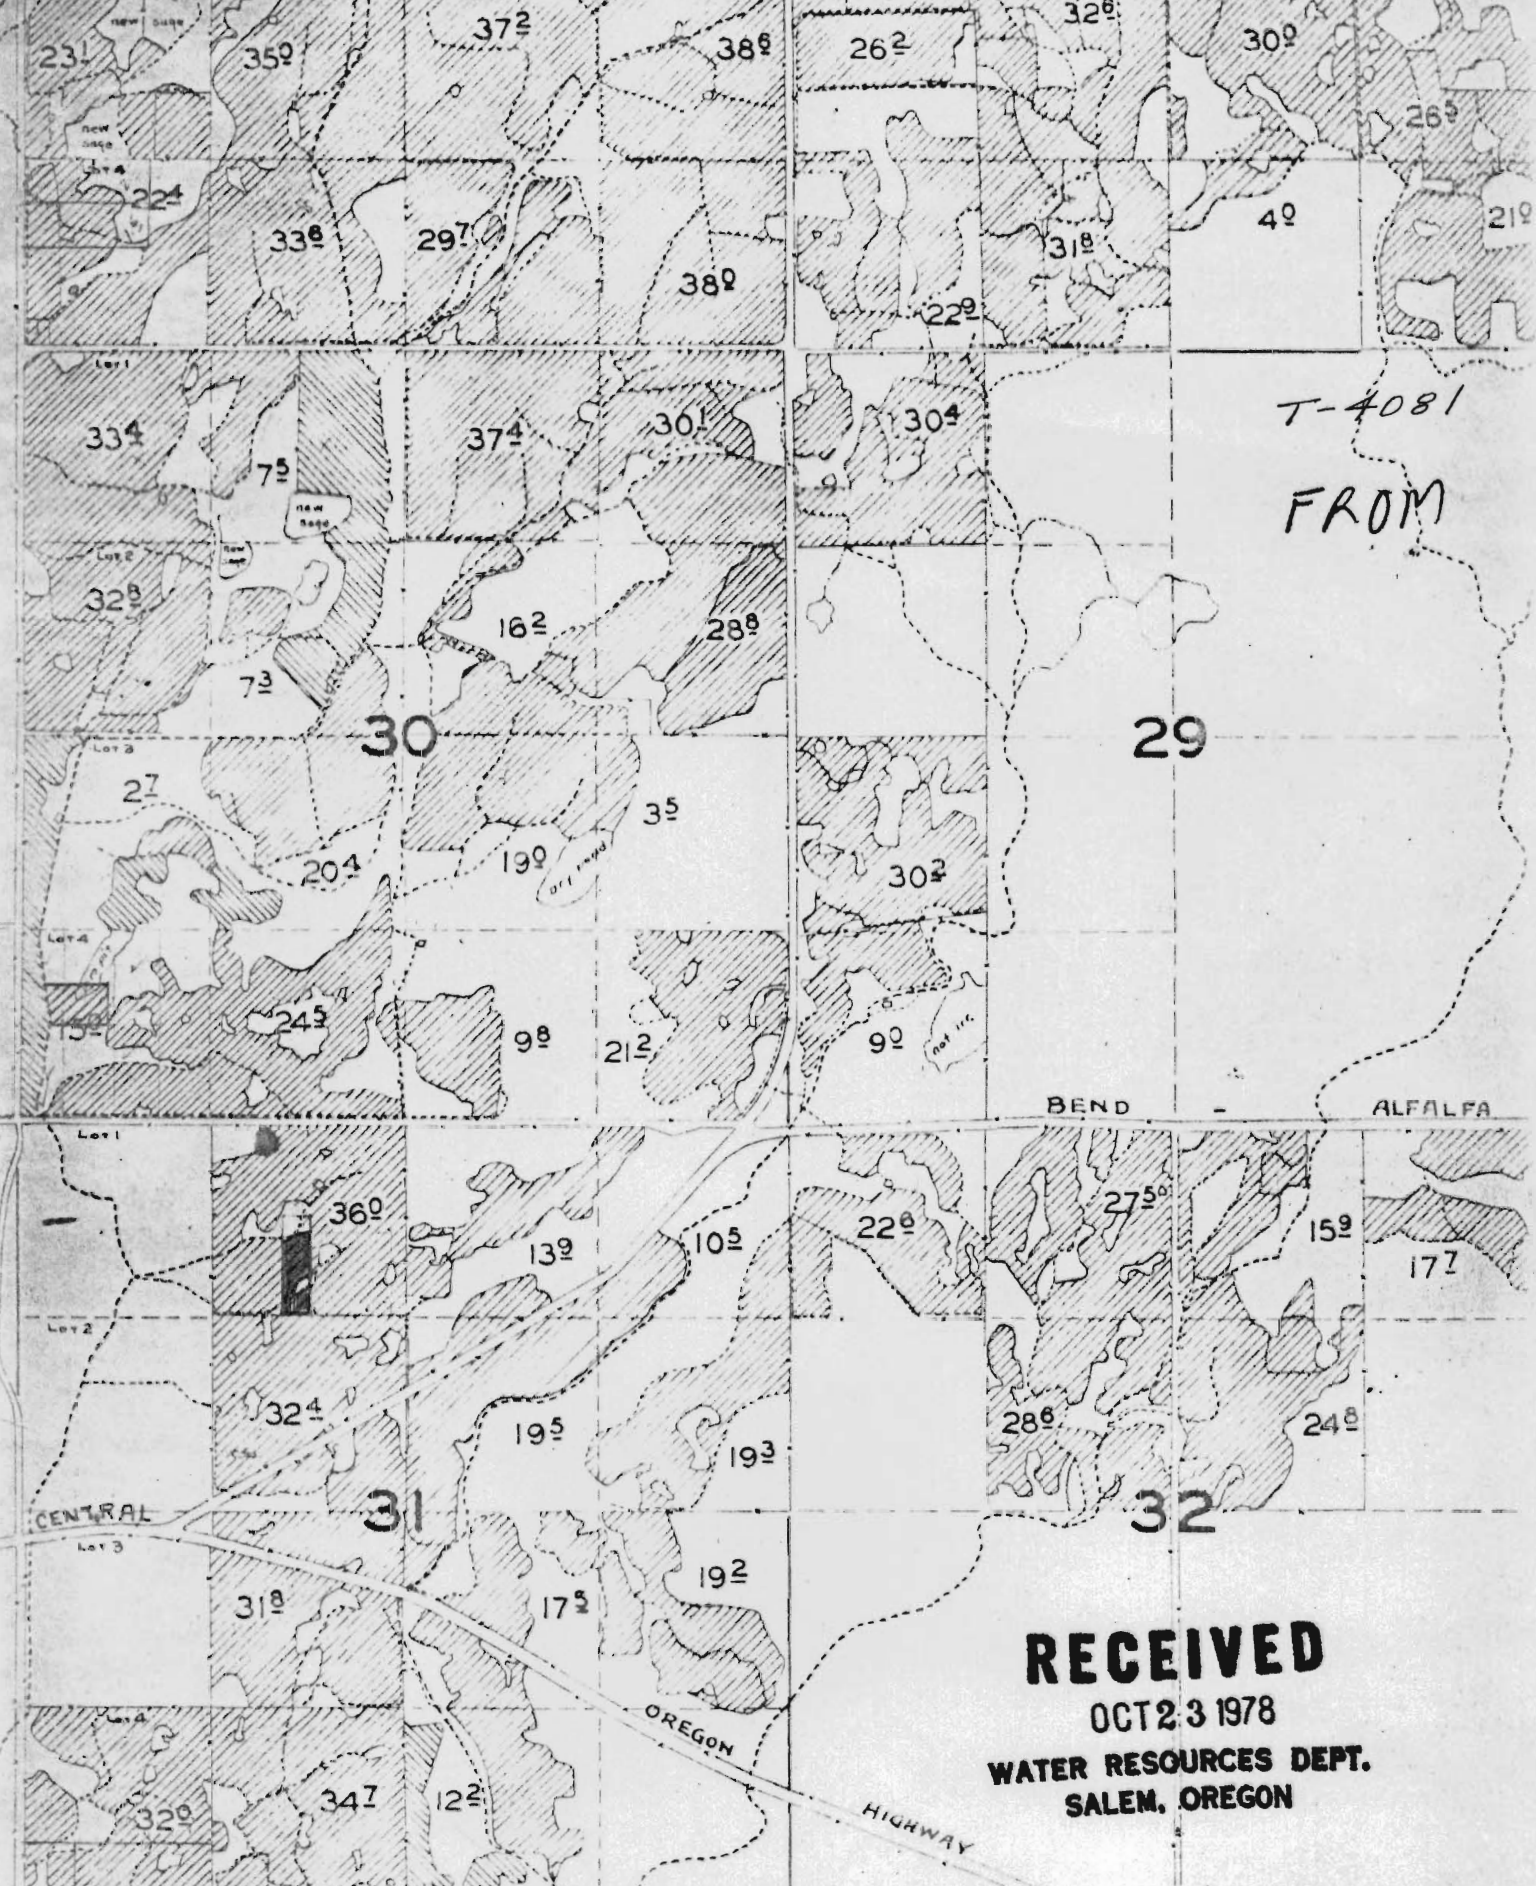

RECEIVED
OCT 23 1978
WATER RESOURCES DEPT.
SALEM, OREGON