

SW 1/4 NE 1/4 Sec. 16 T14 S. R13E W.M.

DESCHUTES COUNTY

OREGON

T-4086
LAND NUMBER 112 "FROM"

14 13

RECEIVED

FEB 25 1981

WATER RESOURCES DEPT
SALEM, OREGON

See Map 14 13 16

See Map 14 13 16 B D

See Map 14 13 16 A D



See Map 14 13 16 U B

14 13


T-4086
"TO"

SE 1/4 NE 1/4 Sec. 16 T.14 S. R.13 E.W.M.
DESCHUTES COUNTY
1"=100'

14 13 16 A D

RECEIVED
FEB 25 1981
WATER RESOURCES DEPT
SALEM, OREGON

See Map H 13 16

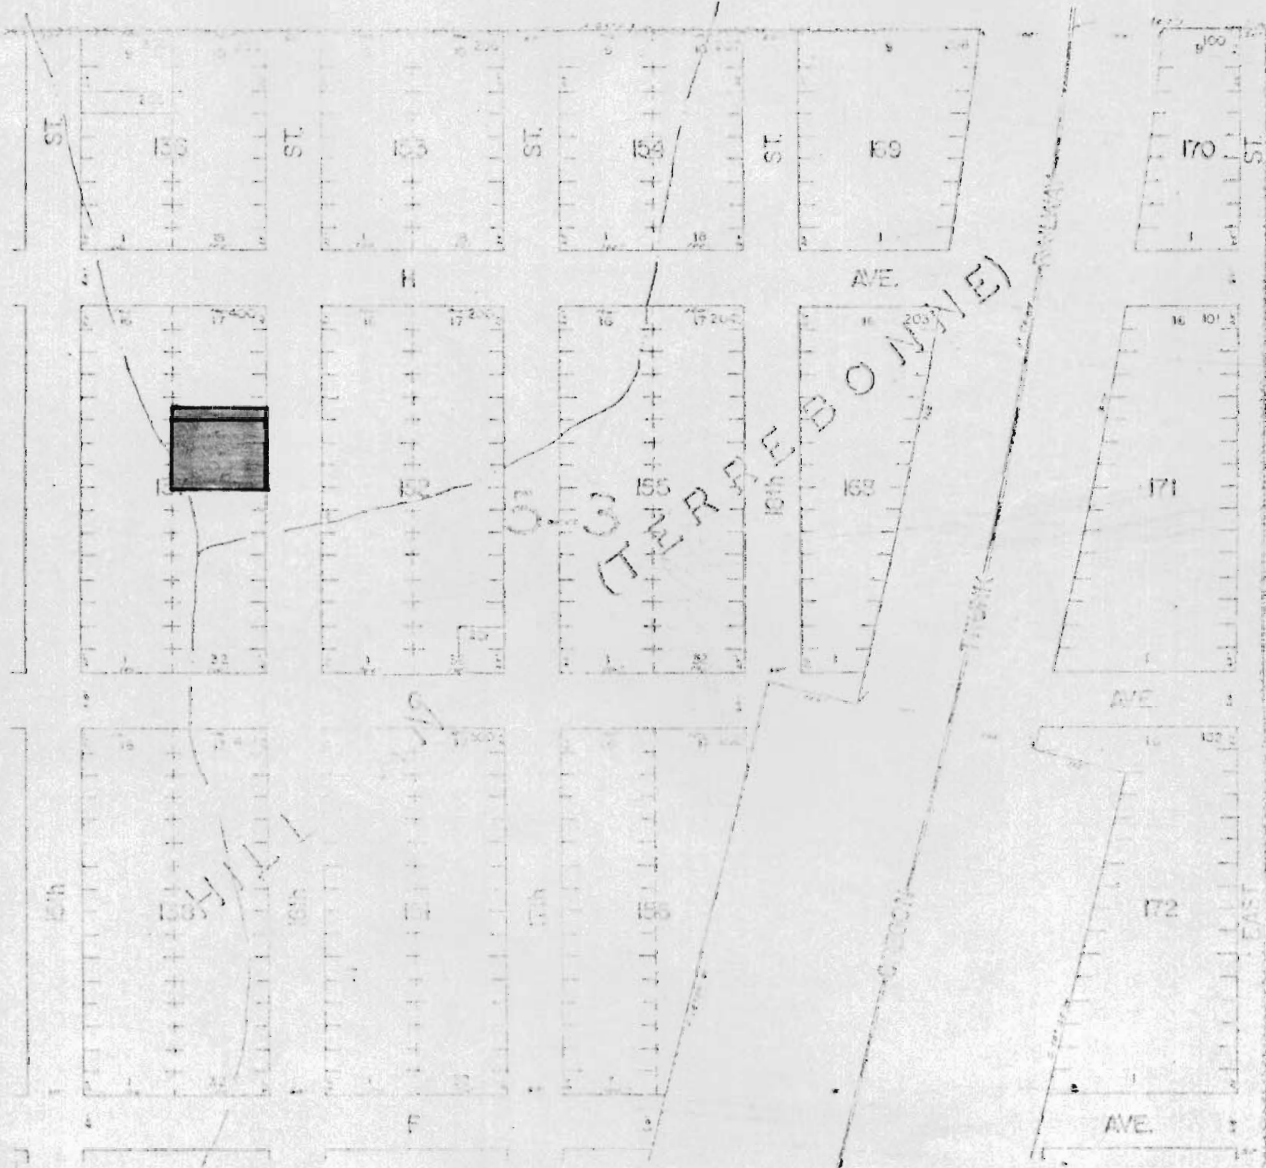

See Map H 13 16

See Map H 13 16

14 13 16 A D