


T.4S.,R.12E.,W.M.

'PRIMARY RIGHTS'

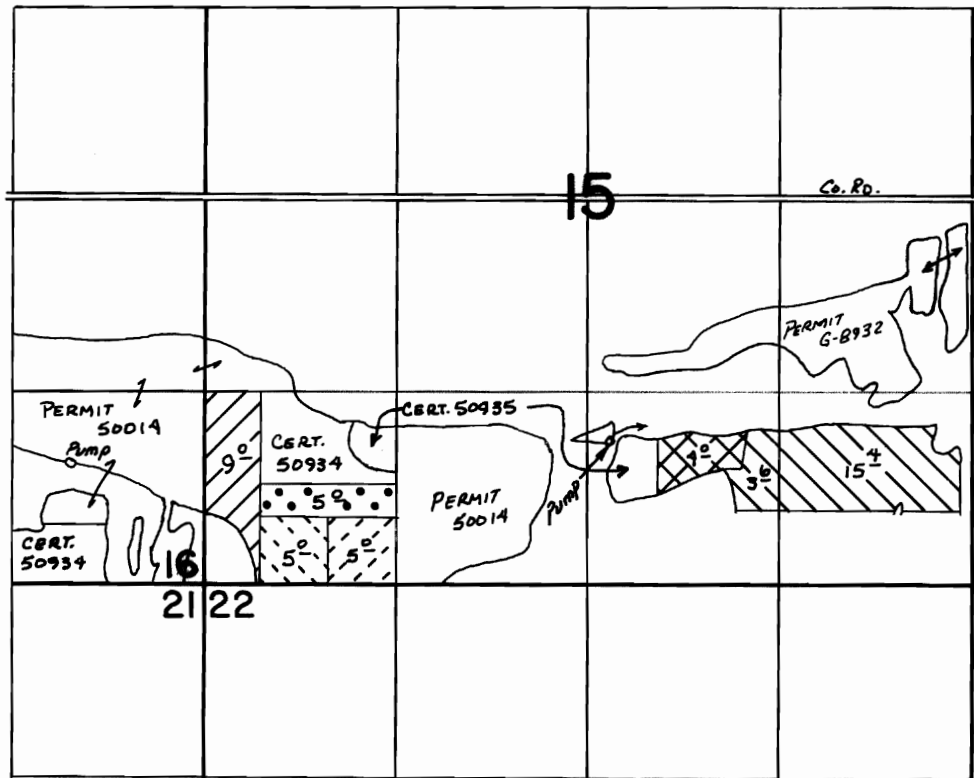

FINAL PROOF SURVEY

UNDER

Transfer No.

Application No. Permit No.

IN NAME OF

LEO E. JILK


Surveyed June...19... 19.84., by ...L...Toll.....

- 4101
- 4103
- 4105
- 4106
- 4107
- 4108



T.4S.,R.12E.,W.M.

'SUPPLEMENTAL RIGHT'

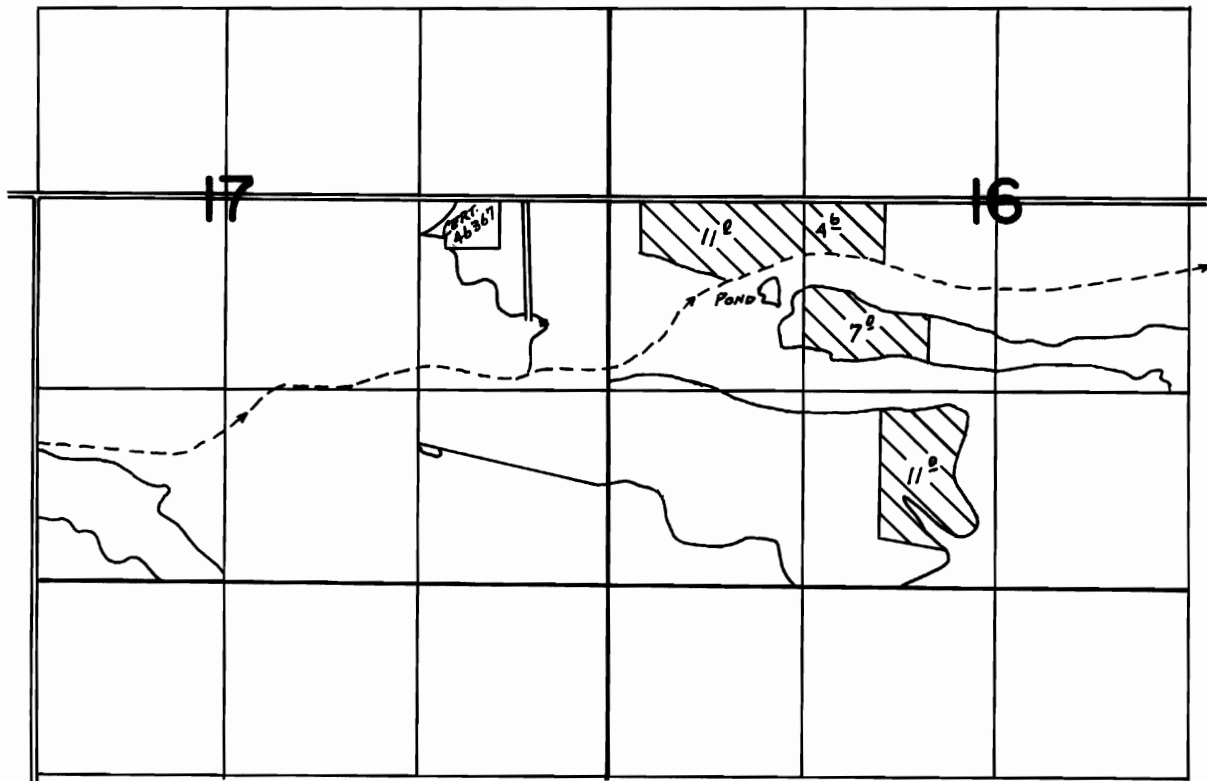

FINAL PROOF SURVEY

UNDER

Transfer No
4101




Application No. Permit No.
IN NAME OF

.....PHYLLIS.....MIZNER.....

Surveyed June 19, 1984, by J.L. Tall.....
June 7 1988 T. Warren

T.4S., R.12E., W.M.

'SUPPLEMENTAL RIGHTS'

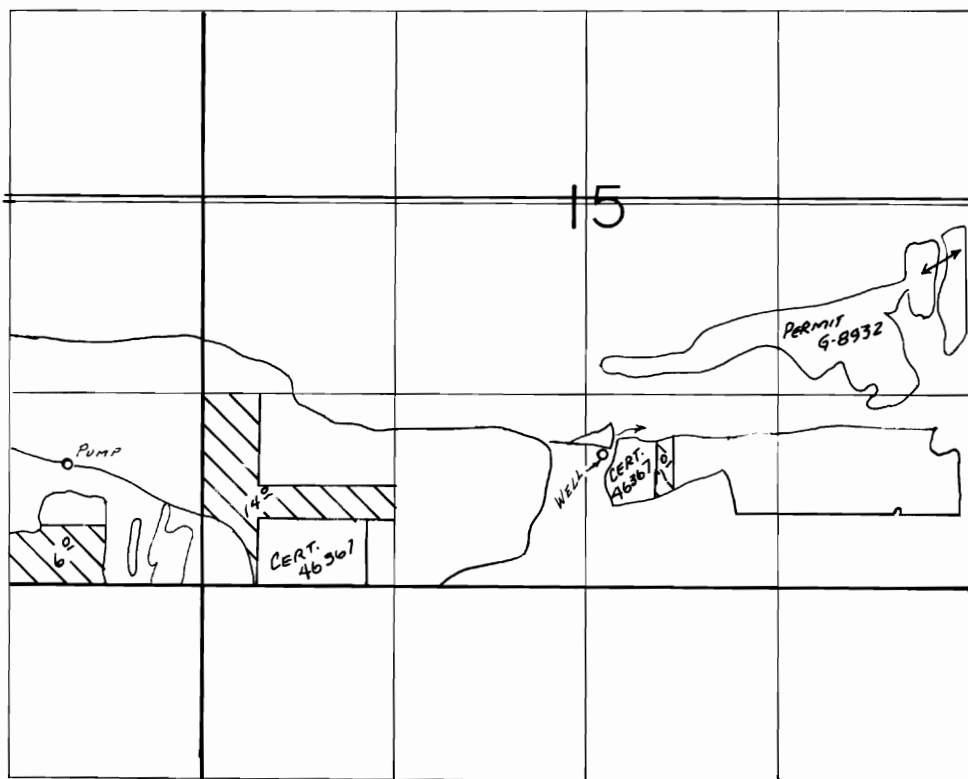

FINAL PROOF SURVEY

UNDER

Transfer No.
4101



Application No. Permit No.

IN NAME OF

LEO E. JILK

Surveyed June 19... 1984, by L. Toll.....