


# T.4S.,R.12E.,W.M.

## 'PRIMARY RIGHTS'

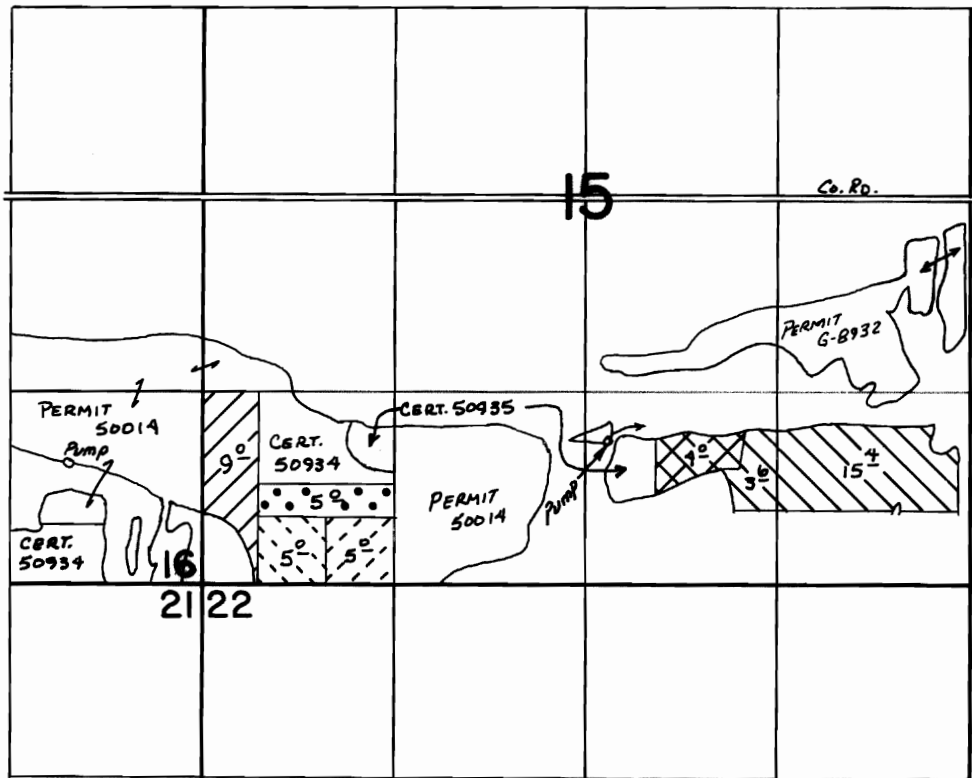

### FINAL PROOF SURVEY

UNDER

Transfer No.

Application No. .... Permit No. ....

IN NAME OF

LEO E. JILK

Surveyed June...19... 19.84., by ...L...Toll.....

- 4101
- 4103
- 4105
- 4106
- 4107
- 4108

