


T.4S.,R.12E.,W.M.

'PRIMARY RIGHTS'

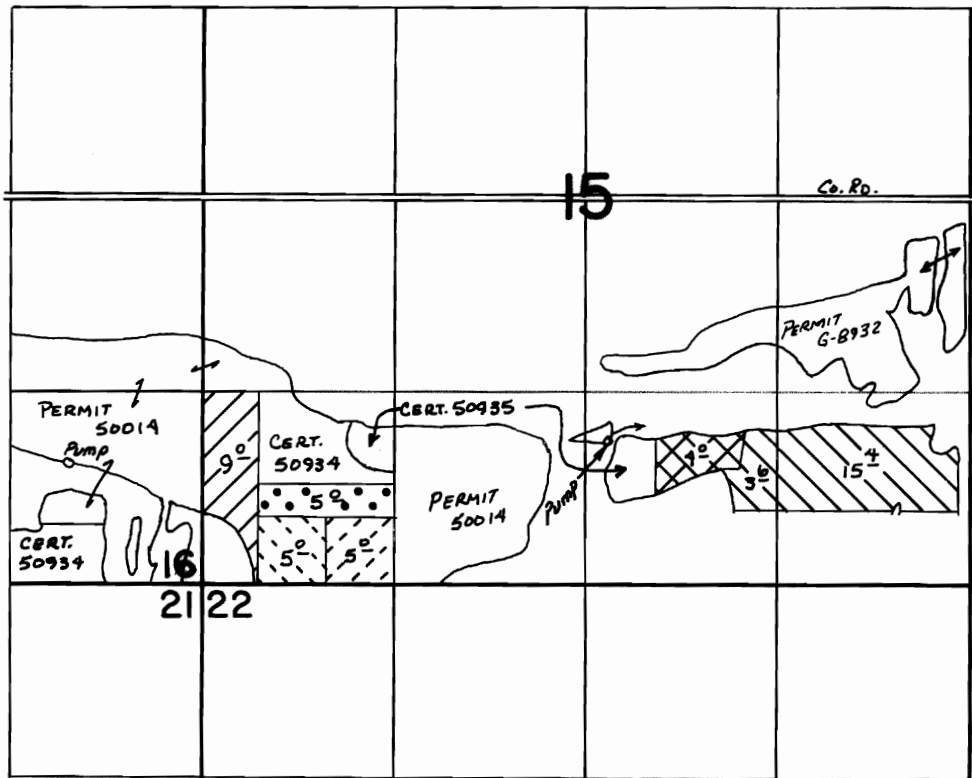

FINAL PROOF SURVEY

UNDER

Transfer No.

Application No. Permit No.

IN NAME OF

LEO E. JILK


Surveyed June...19... 19.84., by ...L...Toll.....

- 4101
- 4103
- 4105
- 4106
- 4107
- 4108



T.4S.,R.12E.,W.M.

'PRIMARY RIGHT'

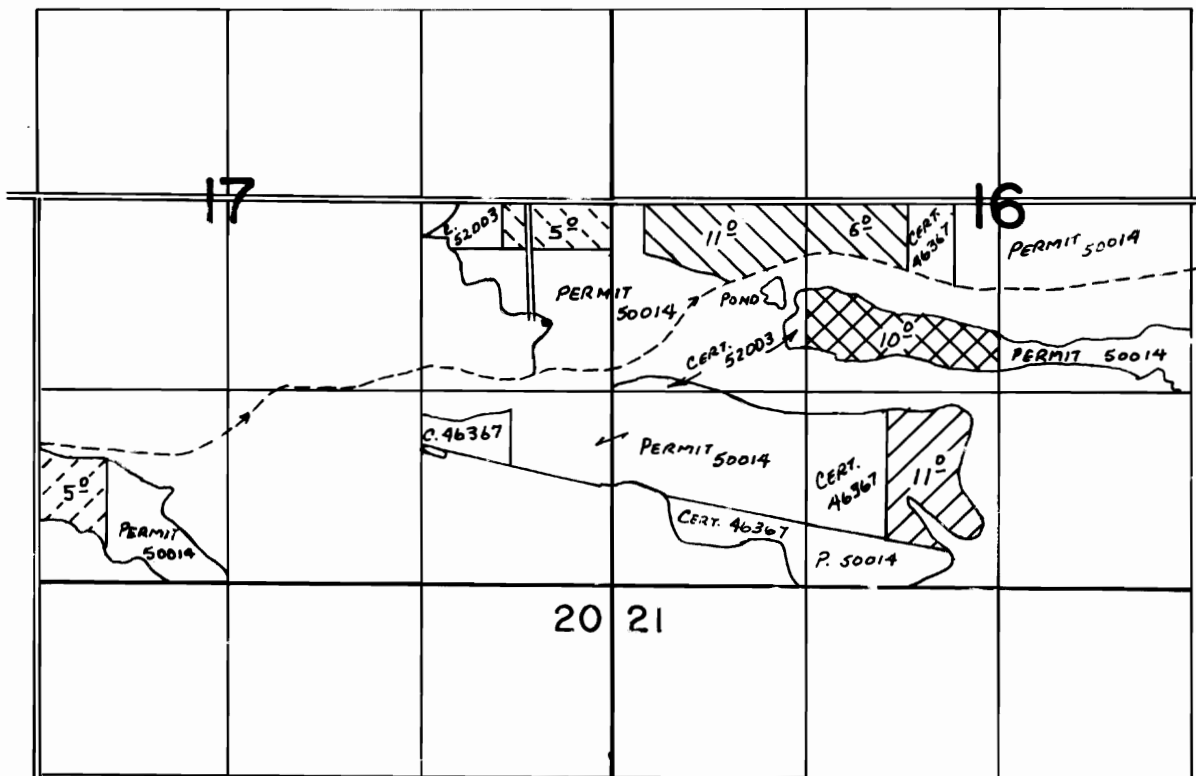

FINAL PROOF SURVEY

UNDER

Transfer No.

Application No. Permit No.

IN NAME OF

..... **PHYLLIS MIZNER**

4103

4106

4108

4947

4948



Surveyed June 19, 1984, by L. Toll

June 7 1988 T. Warren