T. 3N., R. 26E., W.M.

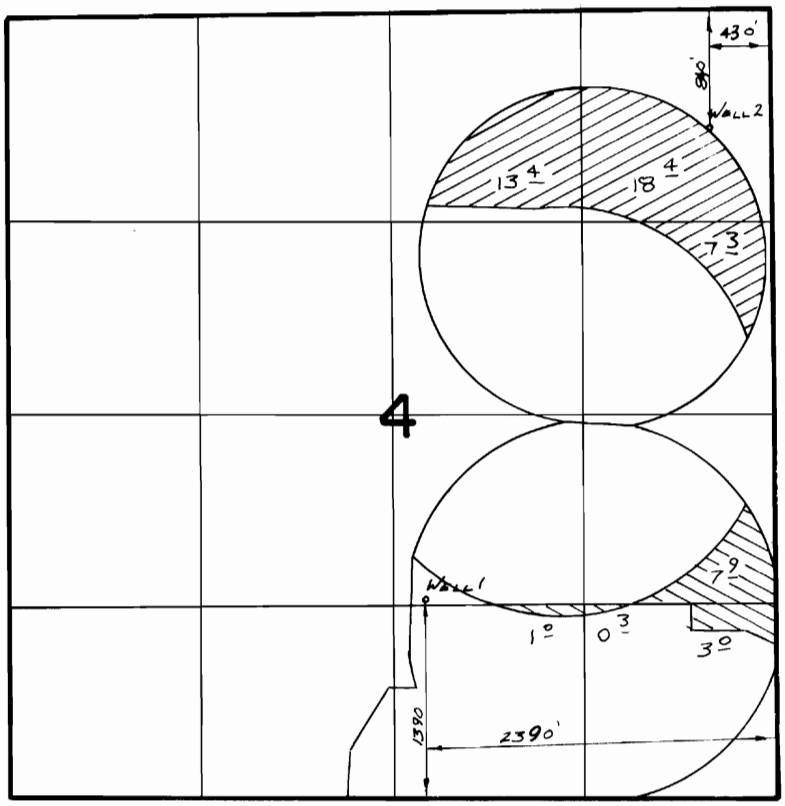

4119

4118

FINAL PROOF SURVEY

UNDER

TRANSFER 4118, 4119

[redacted]

IN NAME OF

GEORGE & JERRY BULOW

Surveyed Nov. 5 1981, by V.L. Church

S.P. Or. V. 33 P. 442
V. 33 P. 444