


T. 3N., R. 26E., W.M.

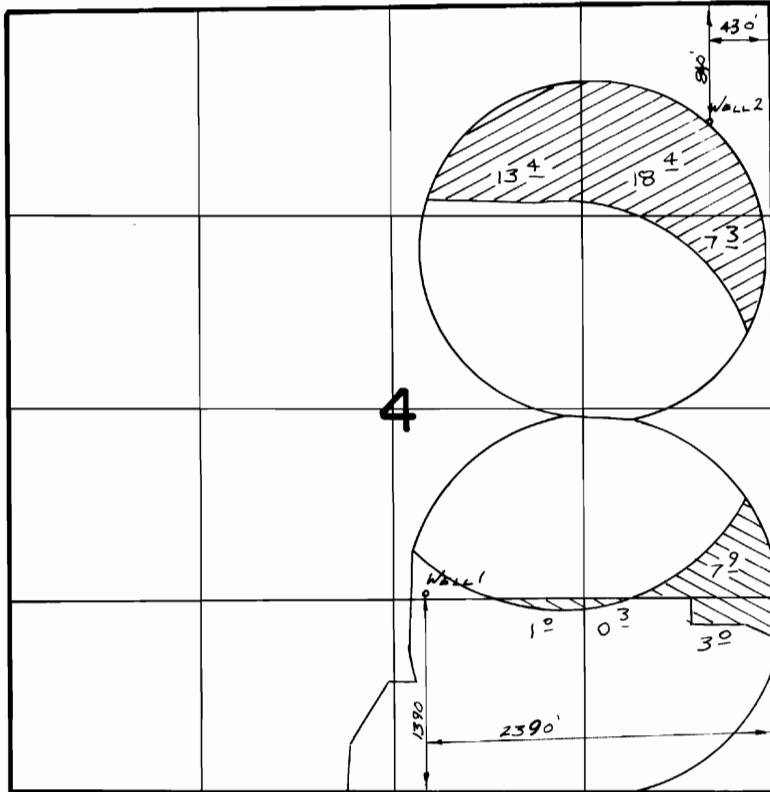

-  4119
-  4118

FINAL PROOF SURVEY
UNDER

TRANSFER 4118, 4119

IN NAME OF

GEORGE & JERRY BULOW

Surveyed Nov. 5, 1981, by *V.L. Church*