


T.18S. R.12E. W.M.

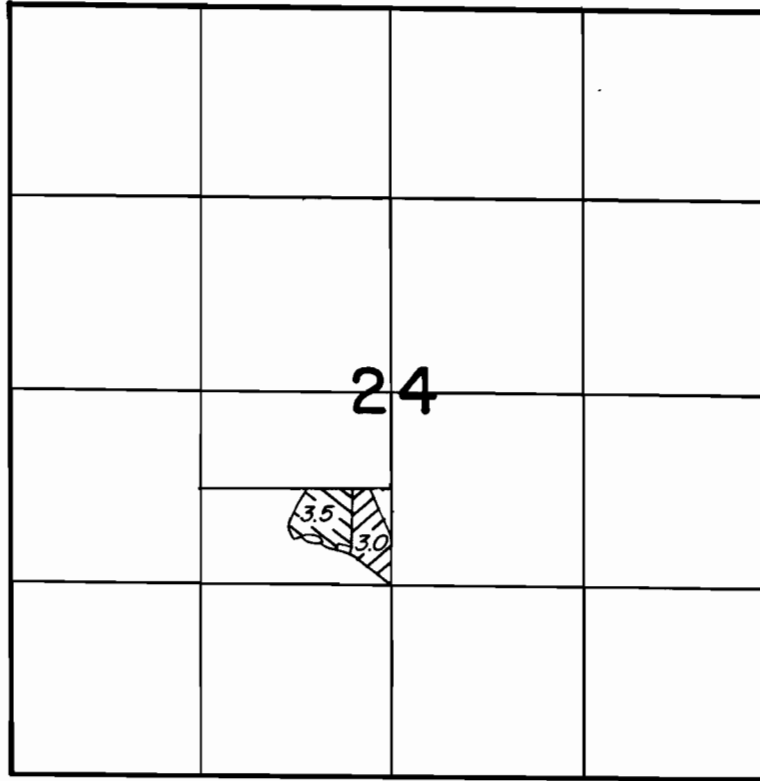

- 3523
- 4129

FINAL PROOF SURVEY

UNDER

PART OF TRANSFER 3523
AND TRANSFER 4129

Application No. Permit No.

IN NAME OF

KENYON THOMPSON

Surveyed JUN. 2 1982, by L.H. NUNN