
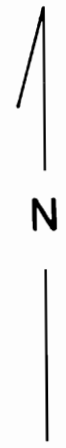


T. 35 & 36 S.  
R. 1 E. & 1 W., W. M.

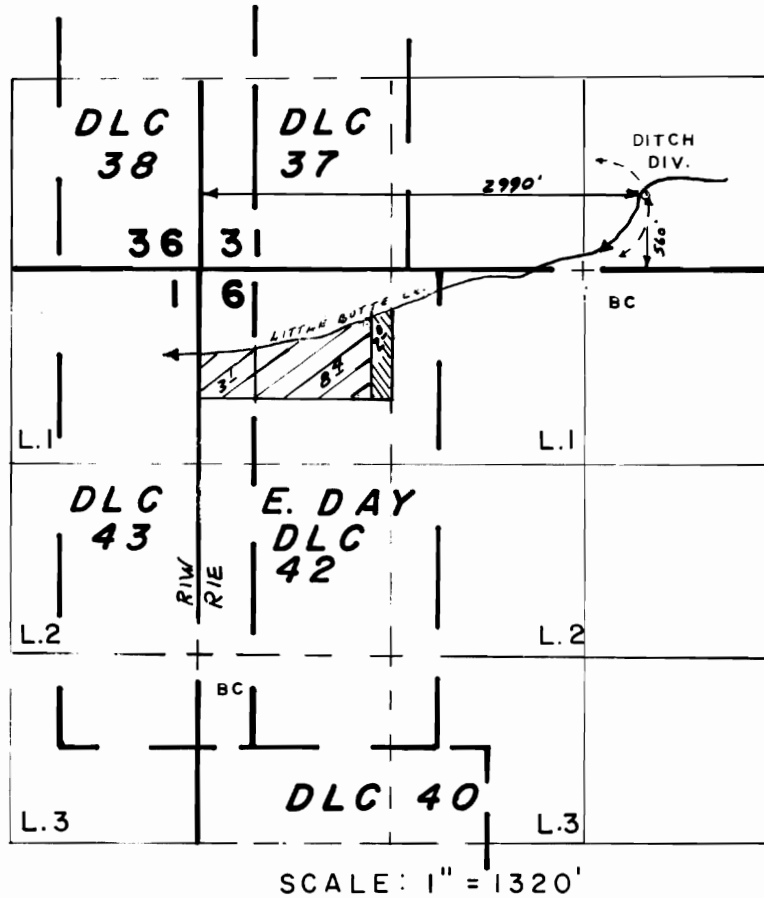

-  1883
-  1908

**FINAL PROOF SURVEY**  
UNDER

TRANSFER NO. 4138

Application No. .... Permit No. ....  
IN NAME OF

**RONALD C. BJORK**

Surveyed OCT. 7, 1985, by B. S. JAMES...