


T-4146

RECEIVED

JUN 18 1977

WATER RESOURCES DEPT  
SALEM, OREGON

T. 1 S. R. 13 E. W.M.

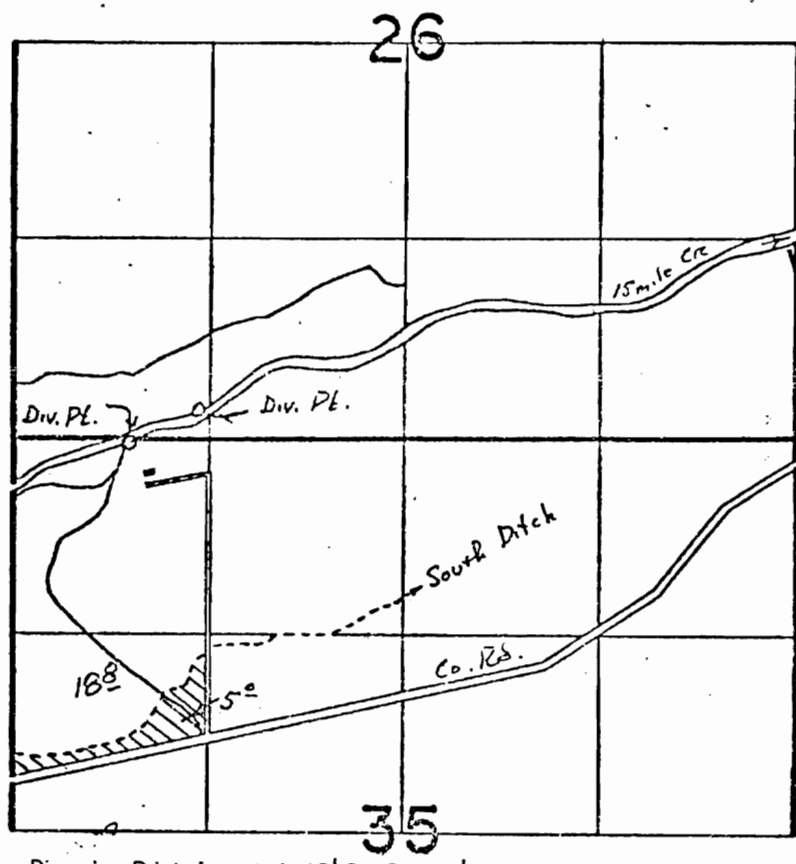

RECEIVED

JAN 25 1979

WATER RESOURCES DEPT.  
SALEM, OREGON

Diversion Points Located: 10' S. & 800' E. from the N.W. corner of Sec. 35

Application Map For

CARLETON RANCH

Scale 4" = 1 Mile