


T.29S. R.5W. W.M.

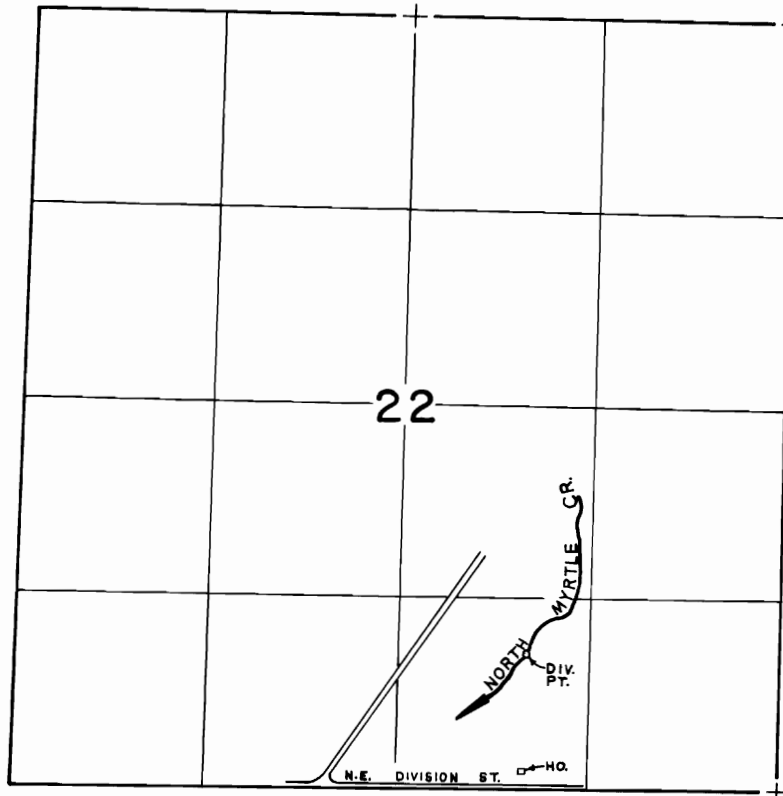

DIV. PT. LOCATED 935' N & 1,710' W. FROM S.E. CORNER SEC. 22

SCALE: 4" = 1 mile

FINAL PROOF SURVEY
UNDER

Application No. Permit No. T-4151..
IN NAME OF

..... **BARBARA D. CLARK**

Surveyed DEC. 22, 1983, by L. CASHION...