




T. 6 & 7 S. R. 39 E. W.M.

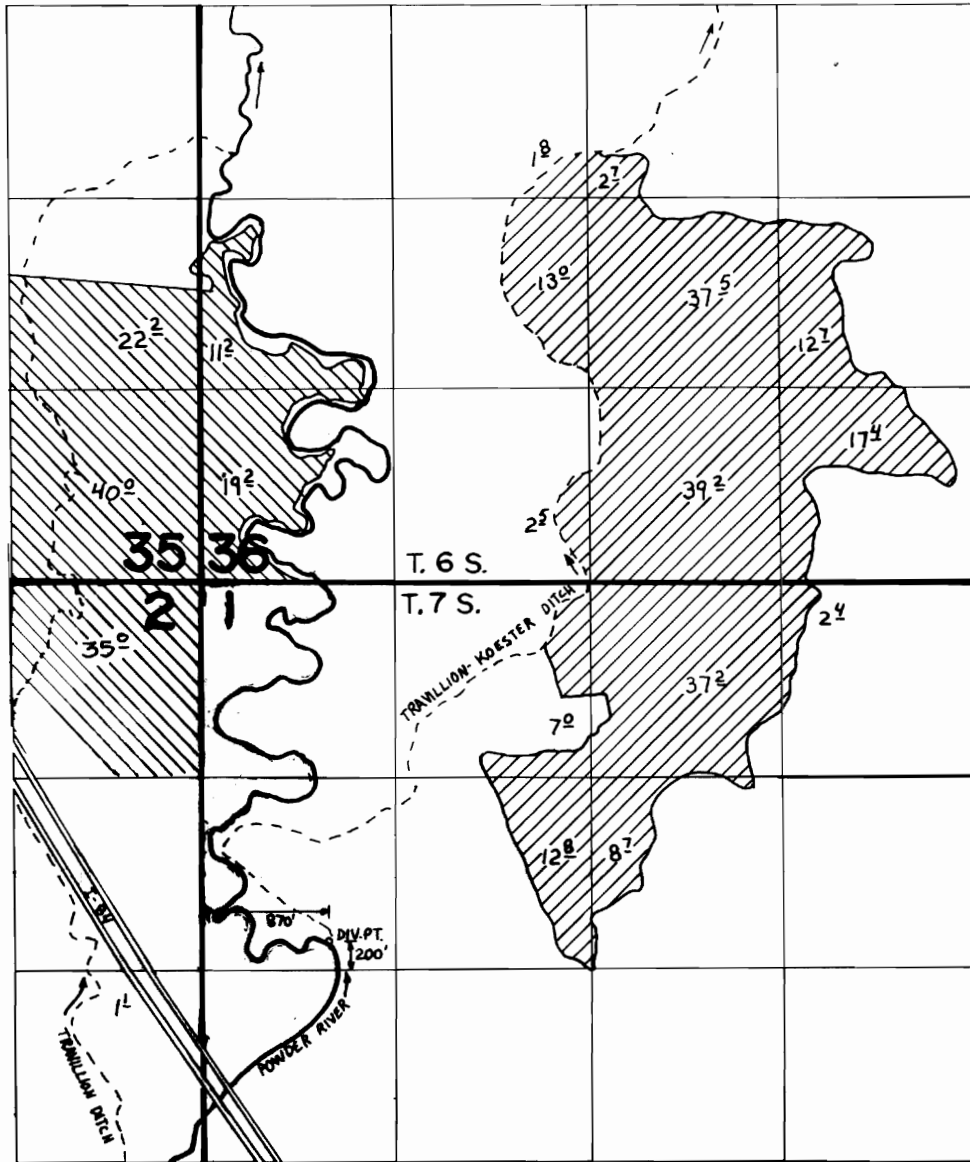


-  T-4161
-  T-4179

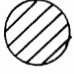

Scale 1" = 1320'

NW 1/4 SECTION 12

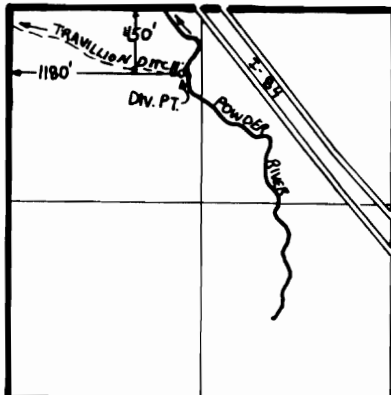

FINAL PROOF SURVEY

UNDER

TRANSFER 4161 & 4179

IN NAME OF

ARTHUR E. POWELL

Surveyed August 26 1986, by V. Church.....