


T.6S. R.1E., W.M.

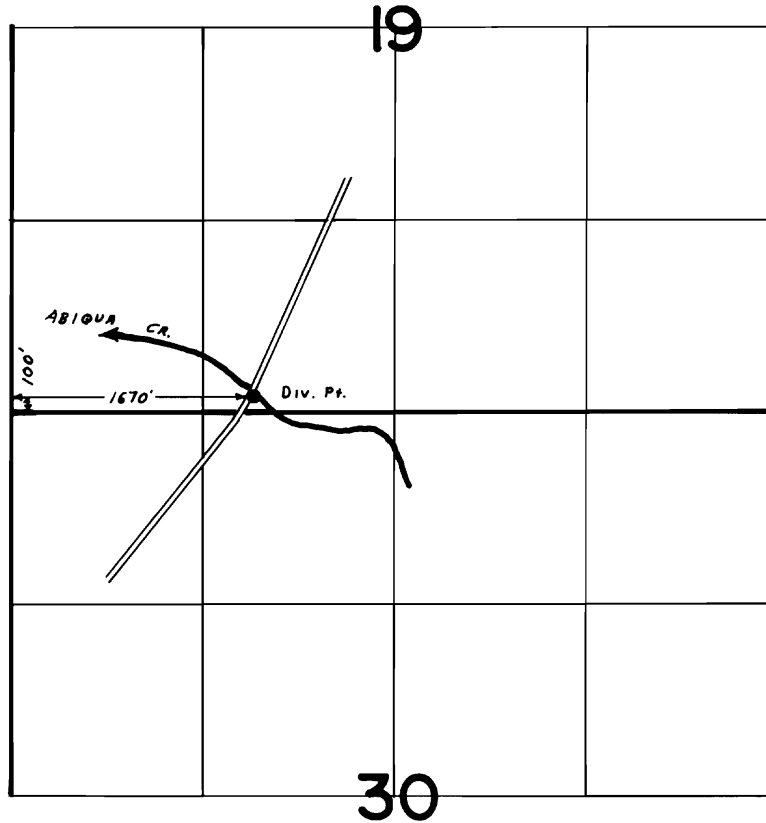

FINAL PROOF SURVEY UNDER

Transfer No. 4169
Application No. Permit No.
IN NAME OF

.....HARRY C. BRITTAN.....

Surveyed JUNE 6... 1979., by L.H. NUNN.....