


T. 9S., R. 40E., W. M.

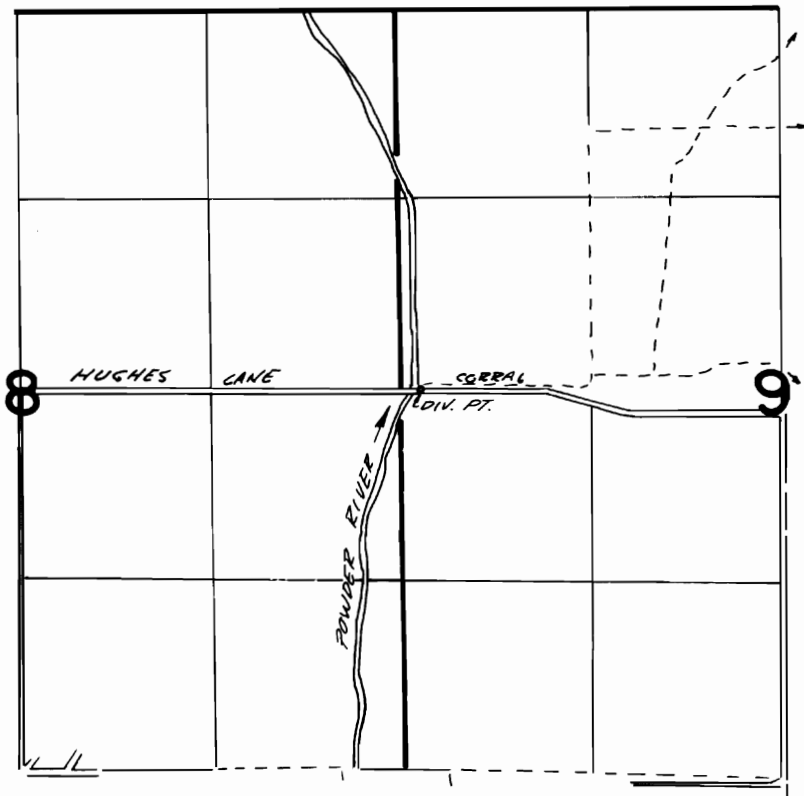

DIV. PT. LOCATED 50' N + 2720' E FROM CENTER SEC 8

FINAL PROOF SURVEY
UNDER

TRANSFER 4171

Application No. Permit No.
IN NAME OF

..... **WAYNE MORRIS**

Surveyed Aug. 5, 1981, by *Harold L. Church*