


T.36 S., R.1W., W.M.
SEC. 6

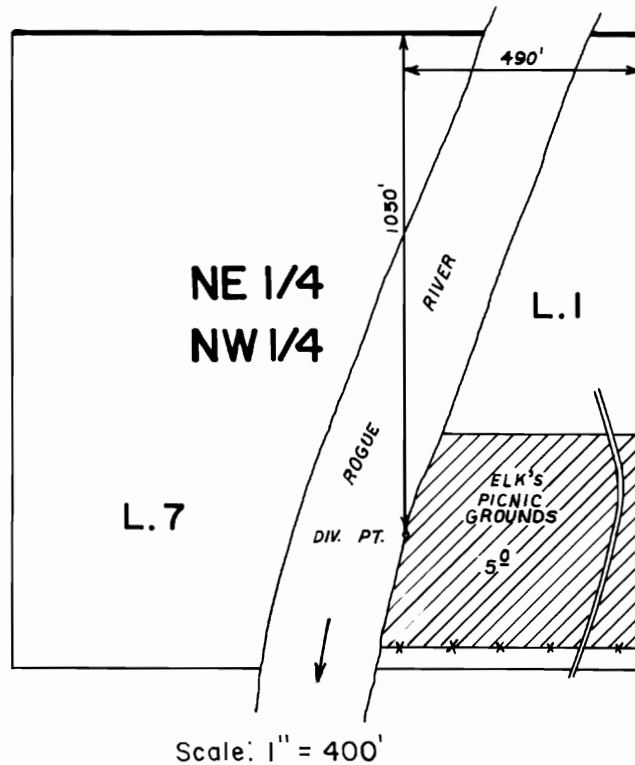

FINAL PROOF SURVEY
UNDER

TRANSFER NO. 4190

Application No. Permit No.
IN NAME OF

TRU-MIX CONSTRUCTION CO.

Surveyed MAY 4 1983, by B. S. JAMES