


T. 6N. R. 35E. W.M.

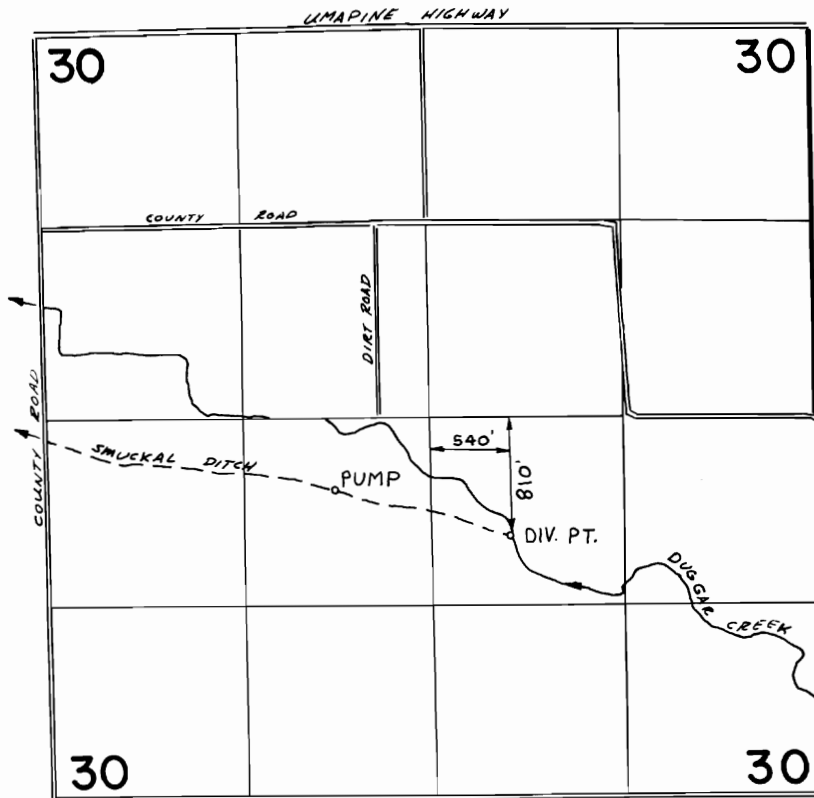

**FINAL PROOF SURVEY**  
UNDER

**TRANSFER 3891 & 4192**

Application No. .... Permit No. ....  
IN NAME OF

**WALTER WHITE**

Surveyed ...10-8... 1980... by *V. Church*.....