
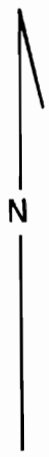


# T.16S., R.11E., W.M.

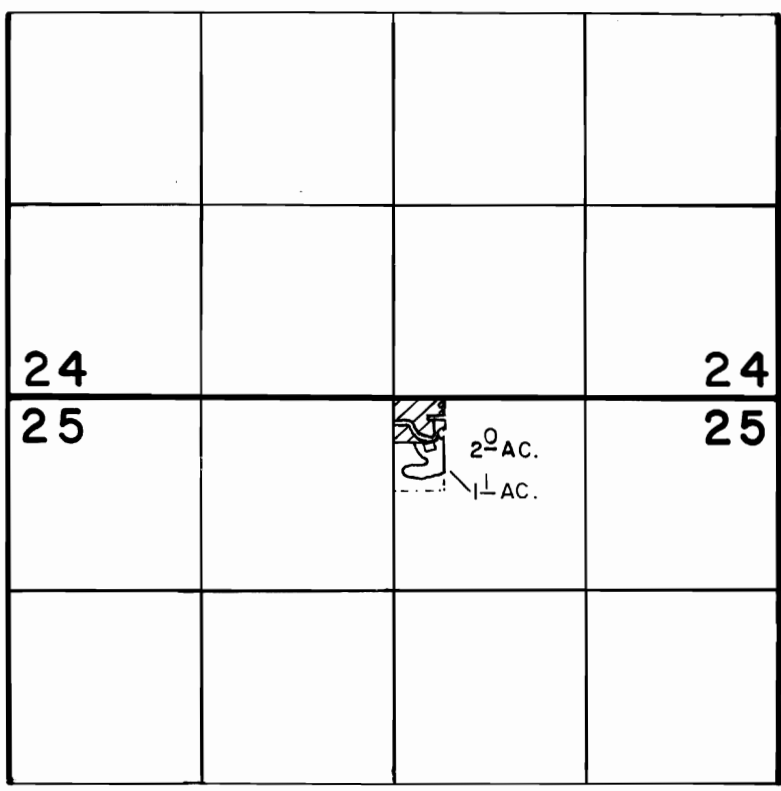

SCALE : 1" = 1320

## FINAL PROOF SURVEY UNDER

TRANSFER NO. 4193

IN NAME OF

..... VERNON PALMER .....

Surveyed SEPT. 5. 1985., by LESLIE OLSON.....