


T. 3S., R. 4 W., W. M.

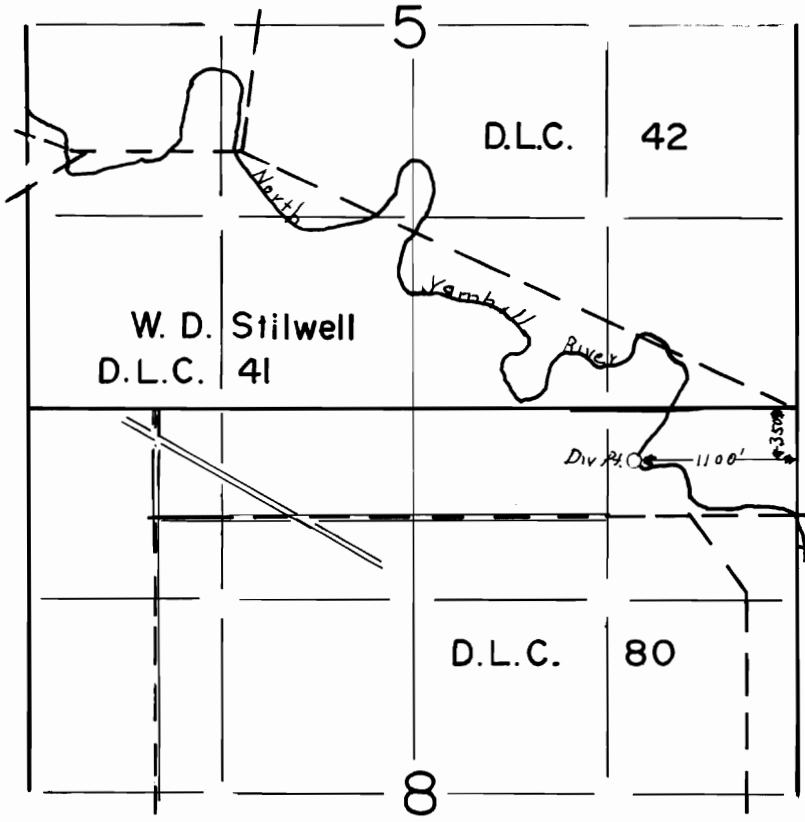

SCALE: 1"=1320'

**FINAL PROOF SURVEY**  
UNDER

Transfer No. 4200

Application No. .... Permit No. ....  
IN NAME OF

.....**VERA TRIVELPIECE**.....

Surveyed OCT..6..... 1987..., by .B.W...**BISHOP**.....