

G 4955


T-4203

**RECEIVED**

APR 19 1979

WATER RESOURCES DEPT.  
SALEM, OREGON

T.3N. R.30E. W.M.

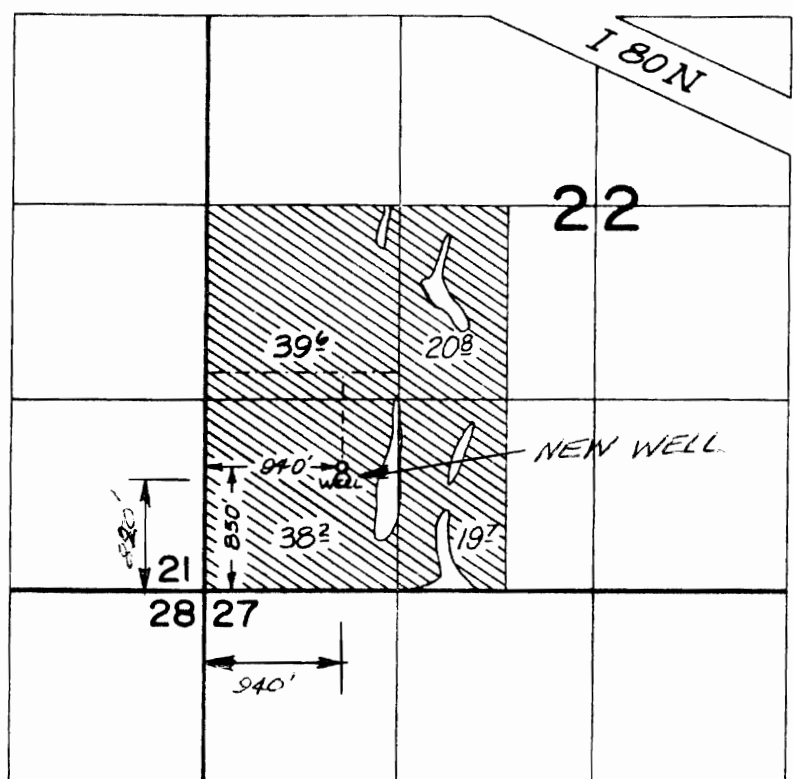

**~~FINAL PROOF SURVEY~~**

~~UNDER~~

*A MAP TO ACCOMPANY A TRANSFER*

~~Application No. G 5717 Permit No. G 4955~~

IN NAME OF

LEON A. REESE

~~Surveyed APRIL 4 1975, by R. G. MUCKEN~~