


T. 12S., R. 4W., W.M.

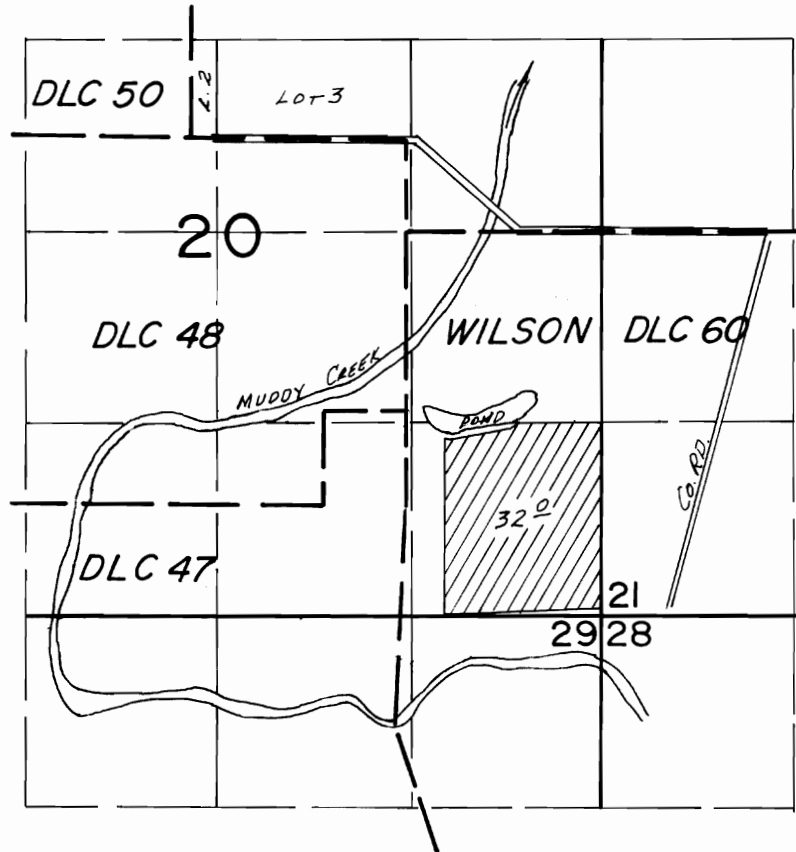

FINAL PROOF SURVEY
UNDER

TRANSFER NO. 4214
Application No. Permit No.
IN NAME OF

HECTOR MACPHERSON dba BANNOCKBURN FARMS, INC.

Surveyed JULY.29. 19.82, by L.M.TOLL.....