


T. 39 S., R. 19 E., W.M.

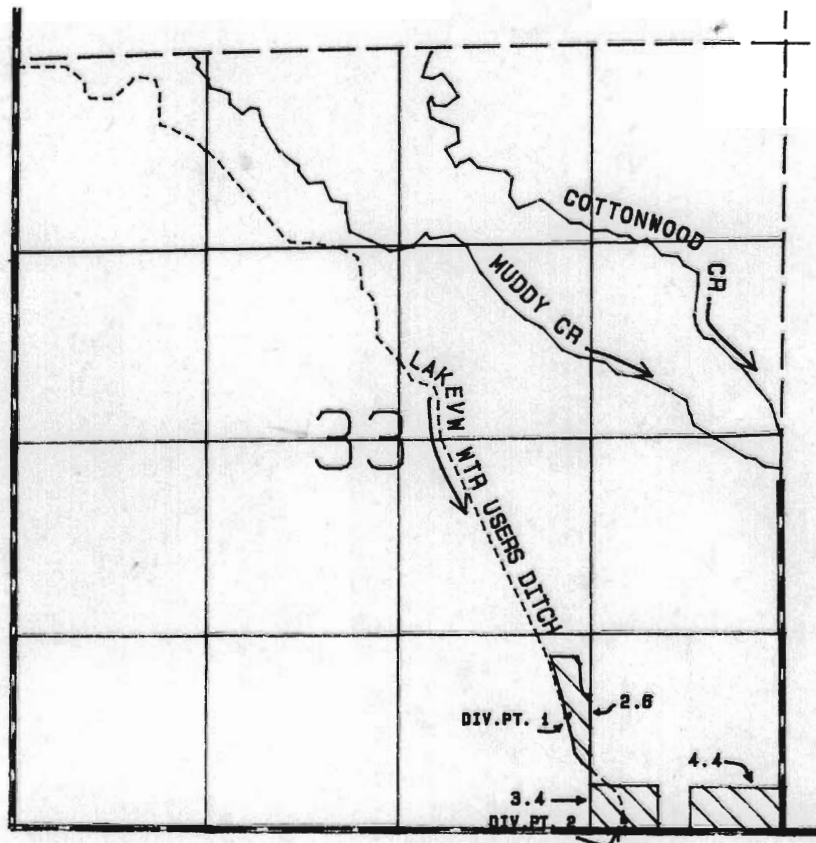

SCALE: 1 = 1320

FINAL PROOF SURVEY
UNDER

TRANSFER 4217

IN NAME OF

Kay C. Clark / LAKEVIEW WATER USERS

Surveyed Oct. 19, 1987 By T.M. Warren

Photo: 379-97L RWK-61S