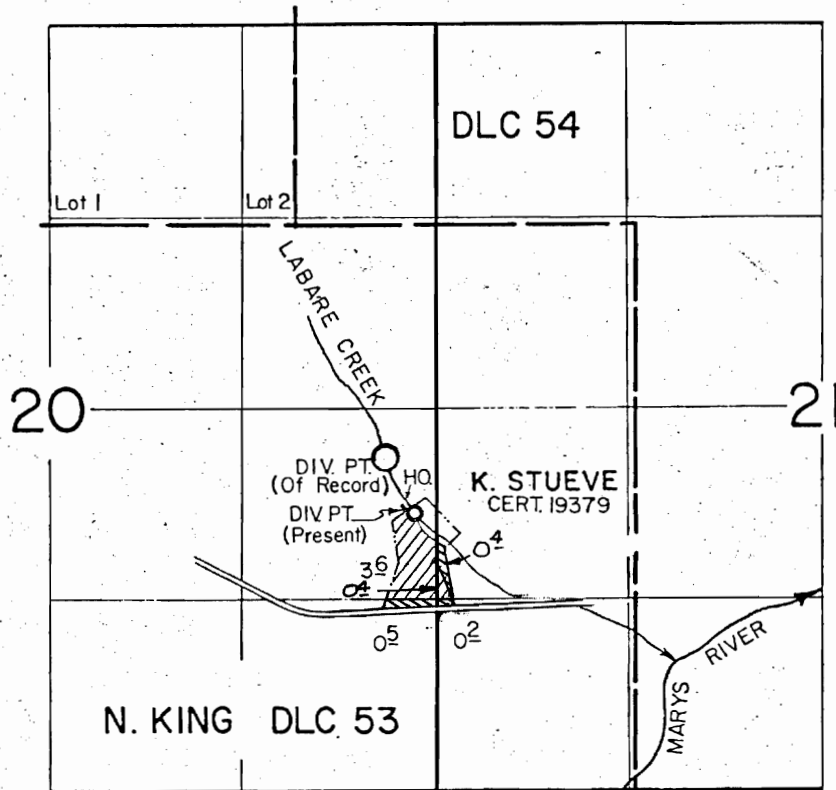

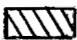


# TOWNSHIP 11 SOUTH, RANGE 6 WEST, W. M.



*Div. Pt. Loc.: 720' S. & 150' W. from E. 1/4 Cor Sec. 20*

-  Permit 14995
-  New application

*Application Map  
under*

Transfer No. -----  
Application No. ----- Permit No. -----

IN NAME OF

*Kenneth P. & A. Carol Stueve*