


T.16S.,R.11E.,W.M.

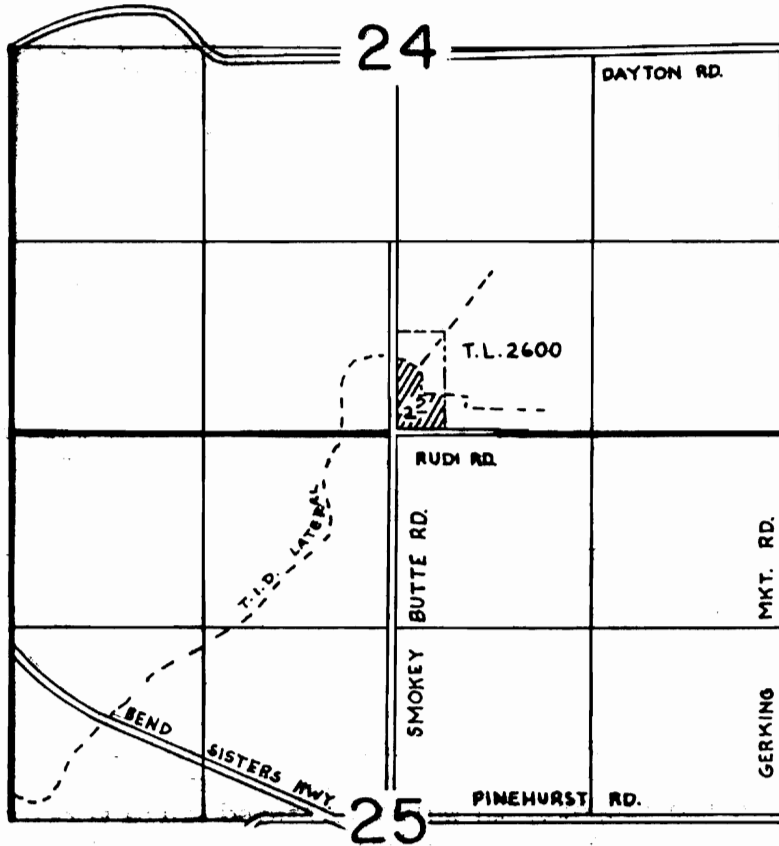

SCALE : 1" = 1320'

FINAL PROOF SURVEY

UNDER

TRANSFER NO. 4222

IN NAME OF

MARGUERITE DAVIS

Surveyed MARCH 5 1985., by LESLIE OLSON....