


T. 6S. R. 6 & 7. W. W. M.

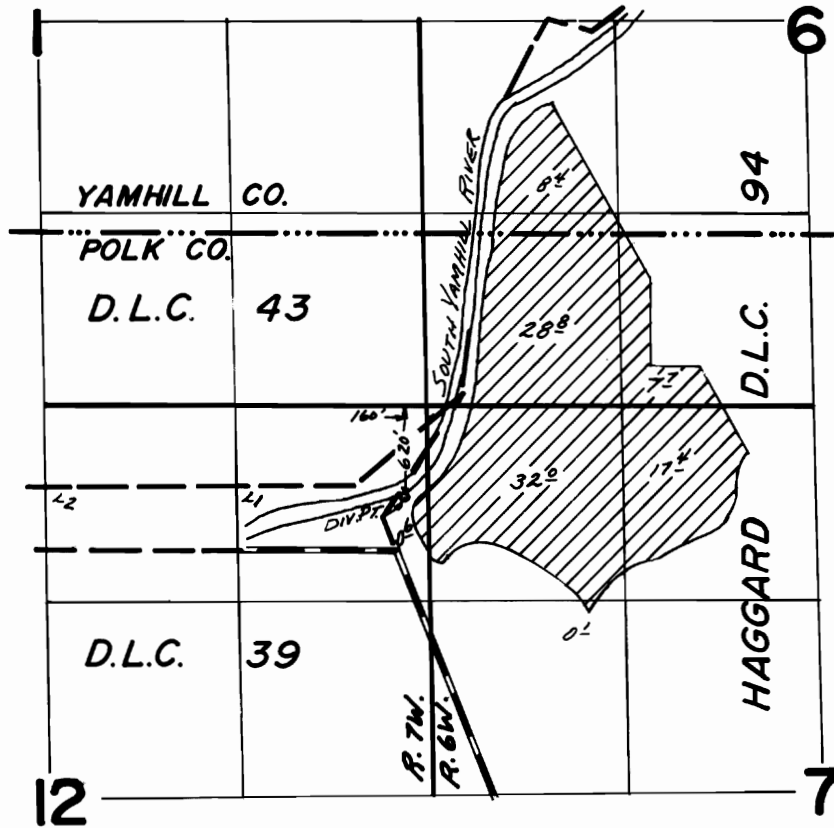

FINAL PROOF SURVEY UNDER

Transfer No. 3971 — (RICHARD KIRKHAM)
Application No. 17,629... Permit No. 13,313...
IN NAME OF

.....WILLIAM SCHULZ.....

Surveyed July 13, 1954, by T. JONES.....