


T. 6S. R. 1E. W.M.

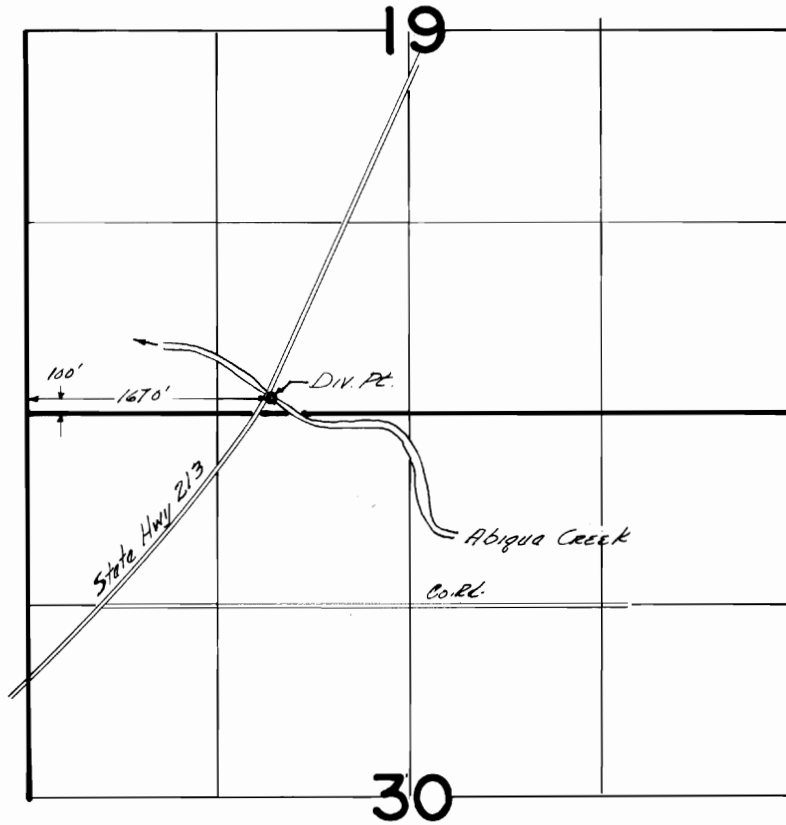

FINAL PROOF SURVEY
UNDER

Transfer No. 4232

Application No. Permit No.

IN NAME OF

..... **DOROTHY WILLYERD**

Surveyed June 6, 1979, by L.H. NUNN

DFN-44-54-100