


T. 5S. R. 1W. W.M.

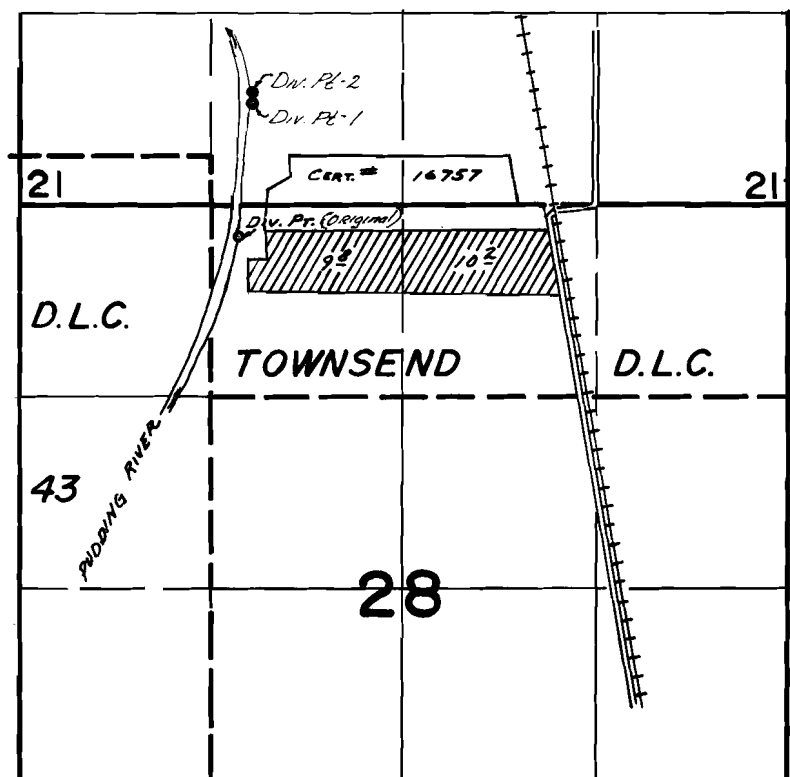

ORIGINAL Div. Pt. Loc. -  $220^{\circ}5' \pm 1120'W$   
TRANSFER No. 4241 - Div. Pt. 1 -  $680^{\circ}N \pm 1040'W$   
TRANSFER No. 4242 - Div. Pt. 2 -  $760^{\circ}N \pm 1040'W$  } ALL FROM N $1/4$   
COR SEC. 28

**FINAL PROOF SURVEY**  
UNDER

Transfer No. 4241  
Transfer No. 4242  
Application No. 55803 Permit No. 41780...  
IN NAME OF

HENRY & AGNES POSTMA

Surveyed Aug. 16, 1978, by J.S. Donaldson  
" Oct. 3, 1979 " C.R. Rodriguez