


T. 6N., R. 35E., W.M.

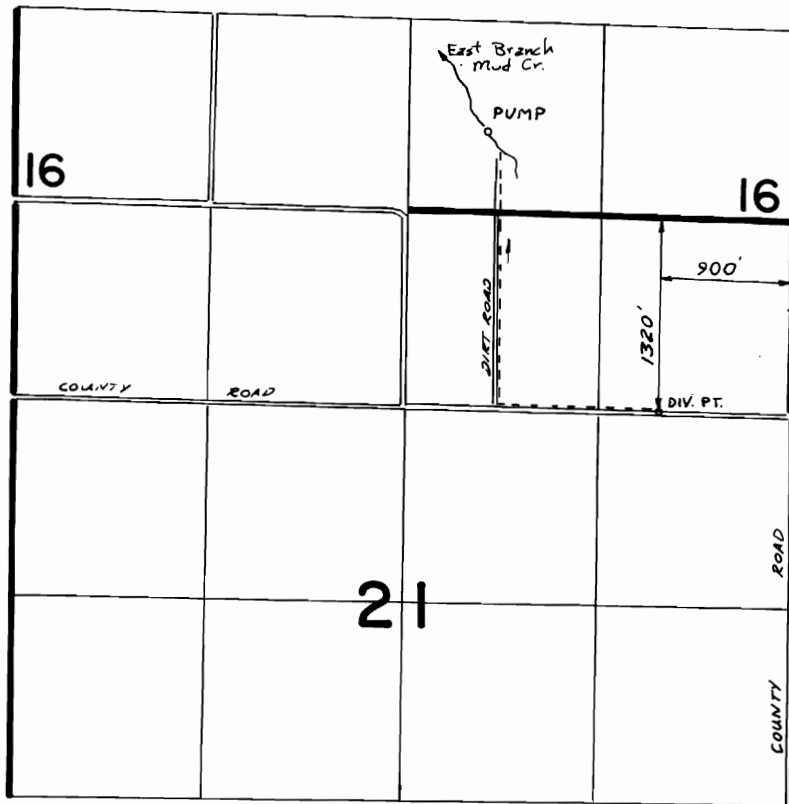

FINAL PROOF SURVEY
UNDER

TRANSFER 4243

IN NAME OF

ROY E. WILKINSON

Surveyed 10-8 1980, by V. Church