


# T. 26 S., R. 3 W., W. M.

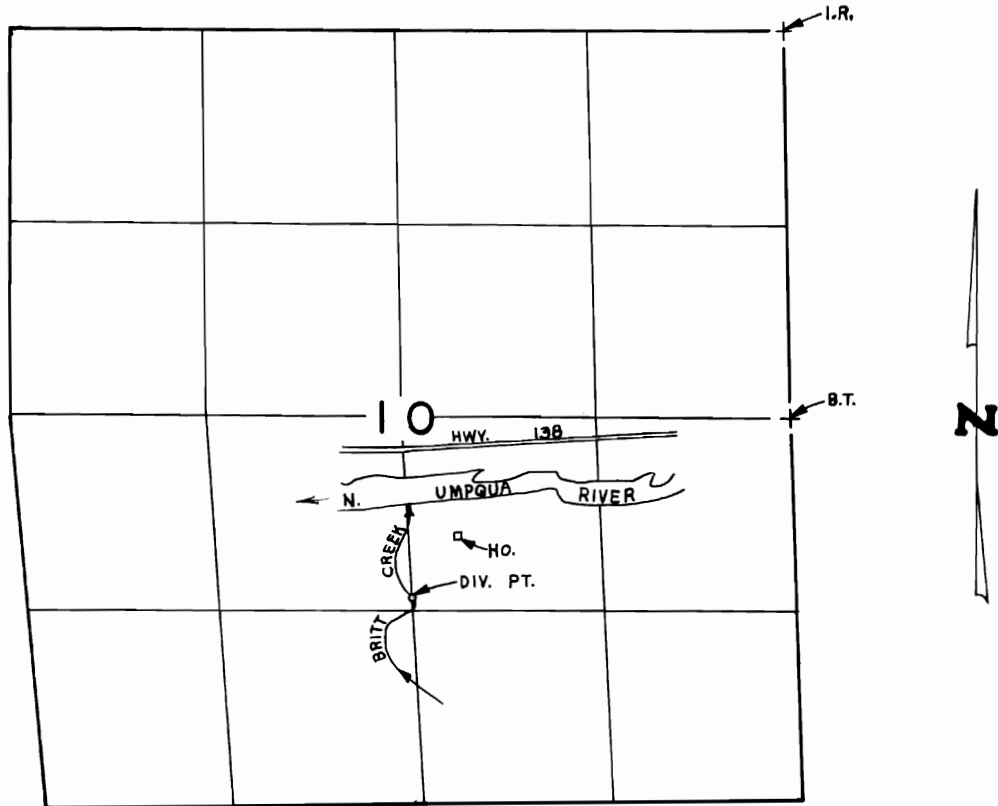

DIV. PT. LOCATED 1,415'N. & 75'W. FROM S. 1/4 COR. SEC. 10

SCALE: 4" = 1 mile

## FINAL PROOF SURVEY UNDER

T-4246

Application No. .... Permit No. ....

IN NAME OF

.....**ANDREW SMITH**.....

Surveyed ..OCT..17, 1984., by ..L..CASHION....