


T. 6N., R. 35E. W.M.

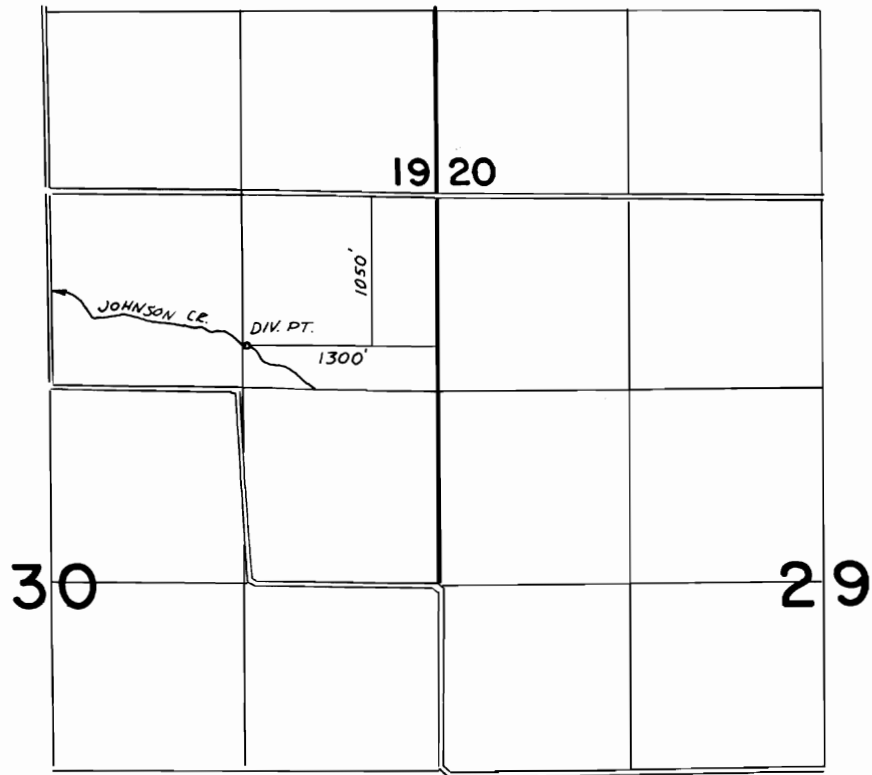

**FINAL PROOF SURVEY**  
UNDER

**TRANSFER 4248**

Application No. .... Permit No. ....

IN NAME OF

..... **CHESTER EARL FORTUNE, JR.** .....

Surveyed 10-8 1980, by V. Church .....