


T.14 S. R. 8 W. W.M.

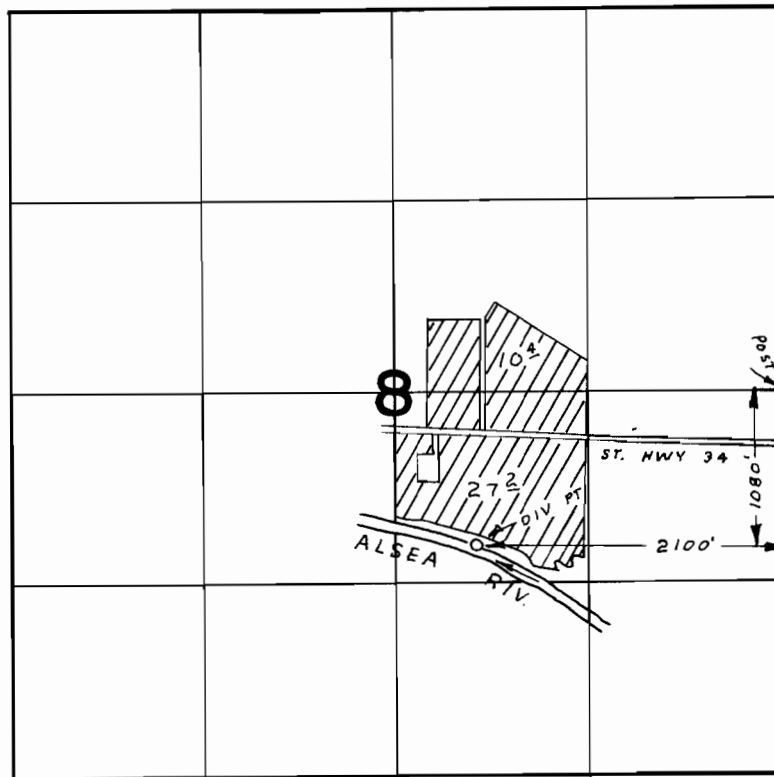

FINAL PROOF SURVEY UNDER

Application No. 47563 Permit No. 35074
IN NAME OF

LLOYD AND BONNETTA COLLEY

Surveyed JUNE 3 1974, by L.H. NUNN