


T. 39S., R. 8W., W.M.

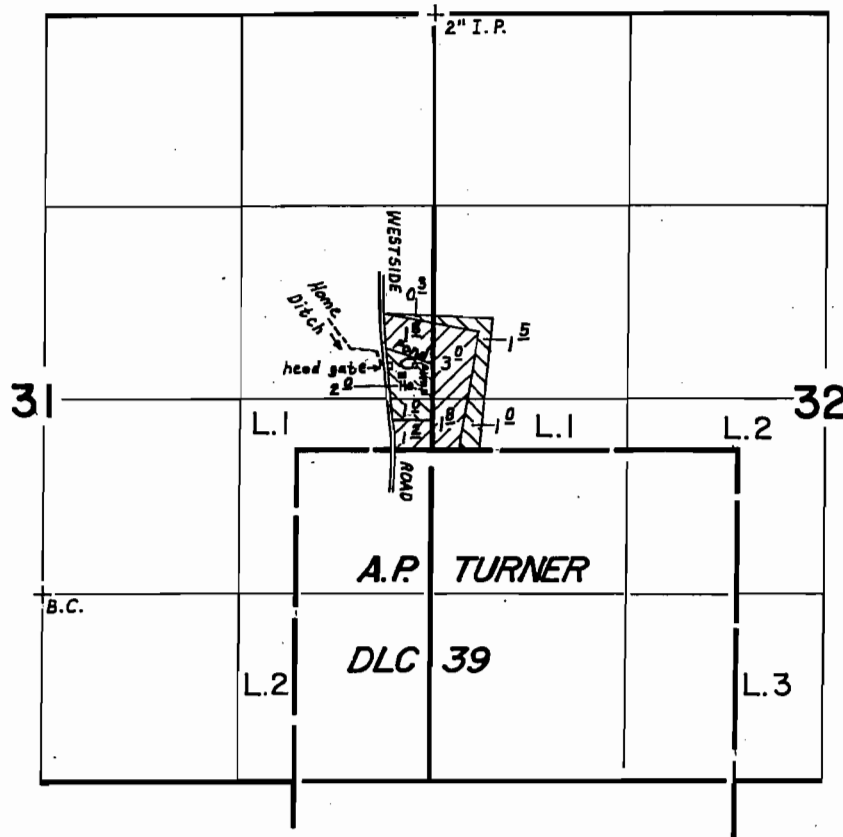

 TRANSFER NO. 4234

 TRANSFER NO. 4253

SCALE: 1" = 1320'

FINAL PROOF SURVEY UNDER

TRANSFER NO. 4234 & 4253

Application No. Permit No.
IN NAME OF

..... **BOB L. JONES**

Surveyed **MAR. 28 1984**, by **B.S. JAMES**