


T. 35 S., R. 1 W., W.M.

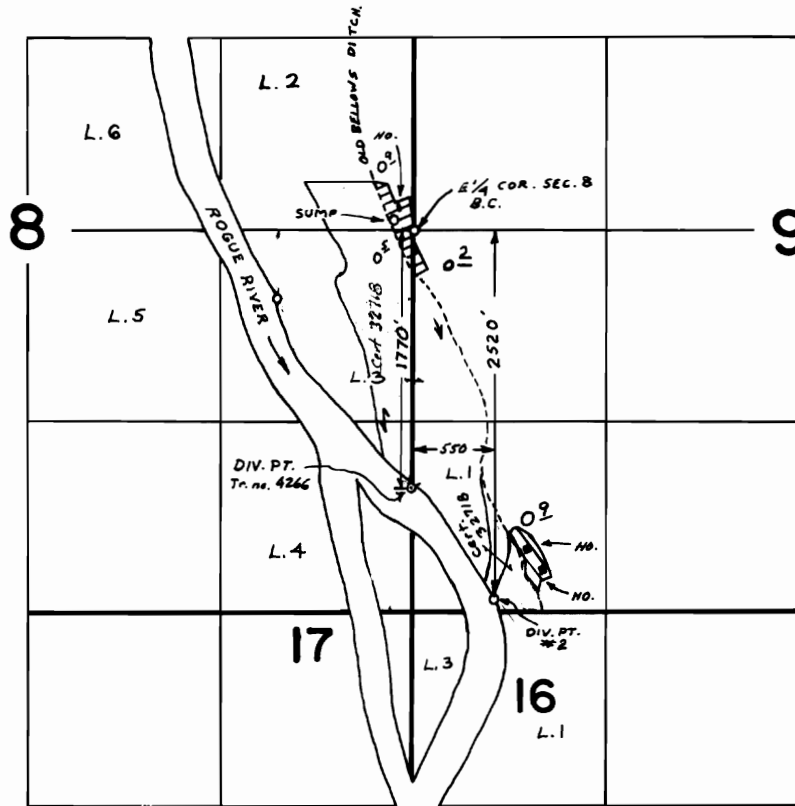

FINAL PROOF SURVEY

UNDER

Transfer No. 2981 Transfer No. 4266
 Transfer No. 2647
 Application No. Permit No.
 IN NAME OF

AUDREY Z. PARSONS

Surveyed MAY 31 1978, by B. SUND