


T. 37 S., R. 6 W., W.M.

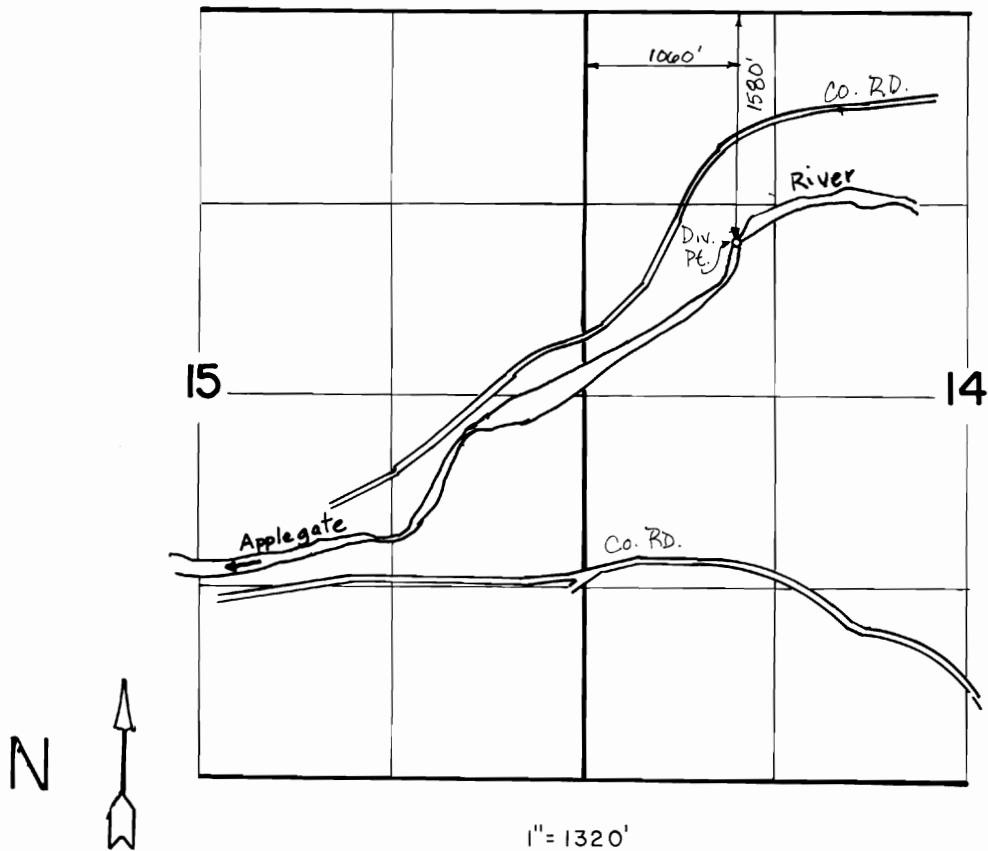

FINAL PROOF SURVEY UNDER

TRANSFER NO. 4270

IN NAME OF

FRED W. WESKE

Surveyed OCT. 19, 1983., by B. S. JAMES.....