


T.7S. R.3W.W.M.

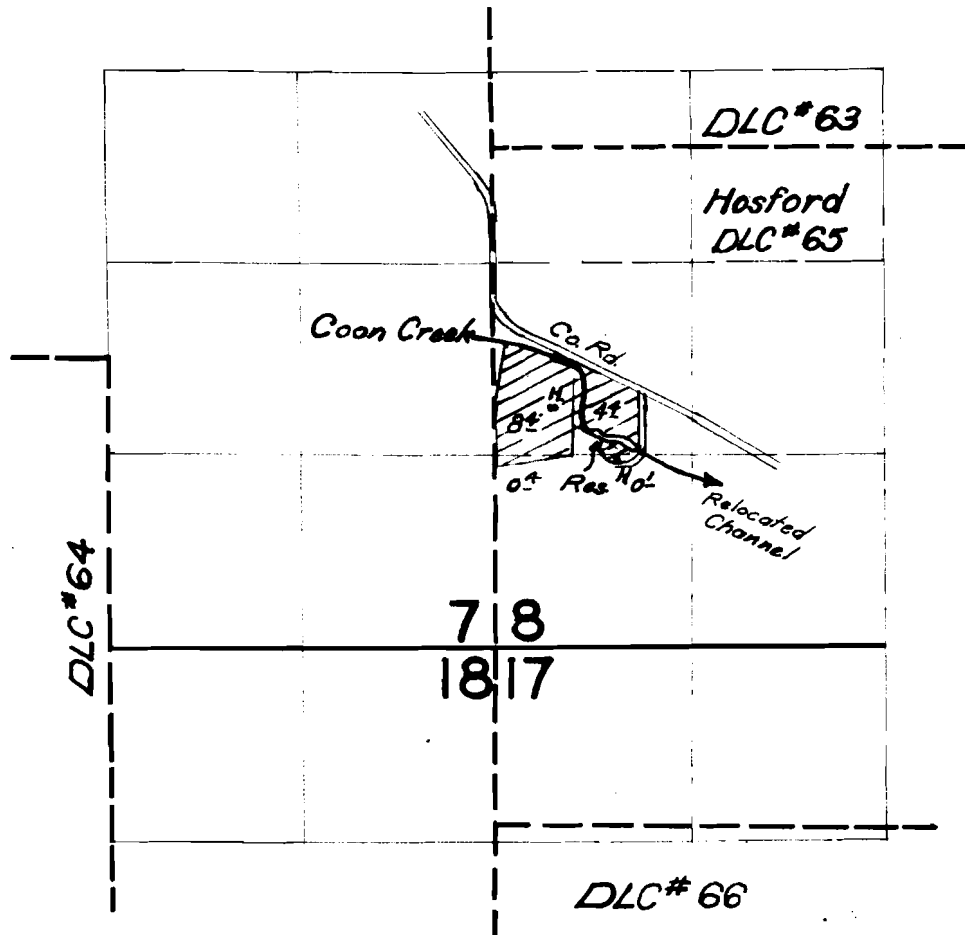

FINAL PROOF SURVEY  
UNDER

R-32455      R-2156  
Application No. 32456      Permit No. 25632  
IN NAME OF

*Gurnee Flesher & Al Friske*

Surveyed 24 July 1962, by *Carl R. Baker*