


T.4S. R.28&3W. W.M.

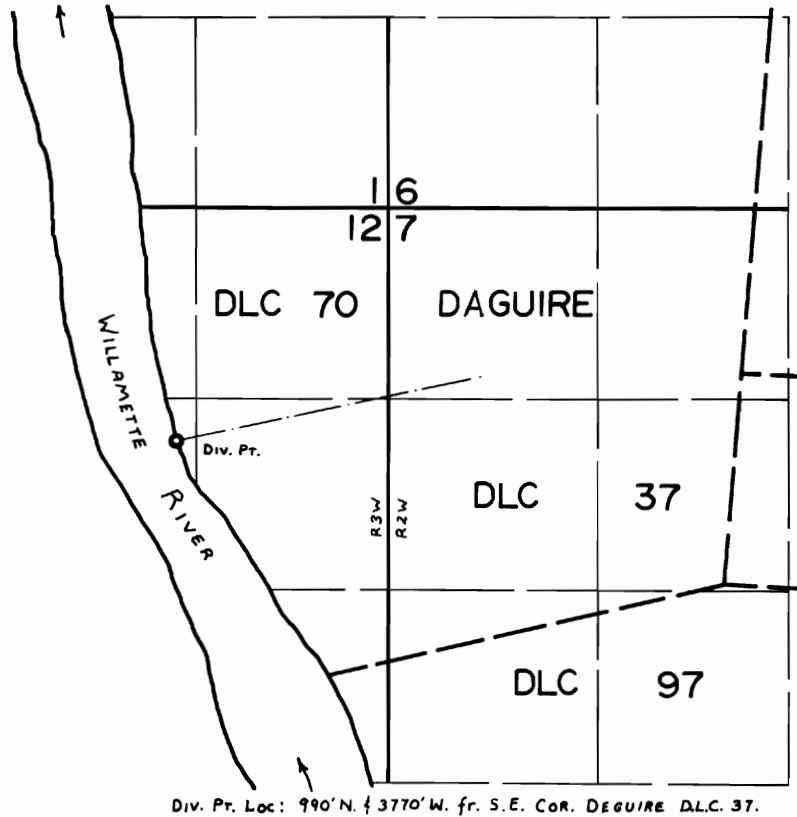

FINAL PROOF SURVEY
UNDER

Transfer No. 4284
Application No. Permit No.
IN NAME OF

.....**IRMA L. CALKINS**.....

Surveyed July 11, 1980, by C. L. Hughes.....