


T.20S.,R.46E.,W.M.

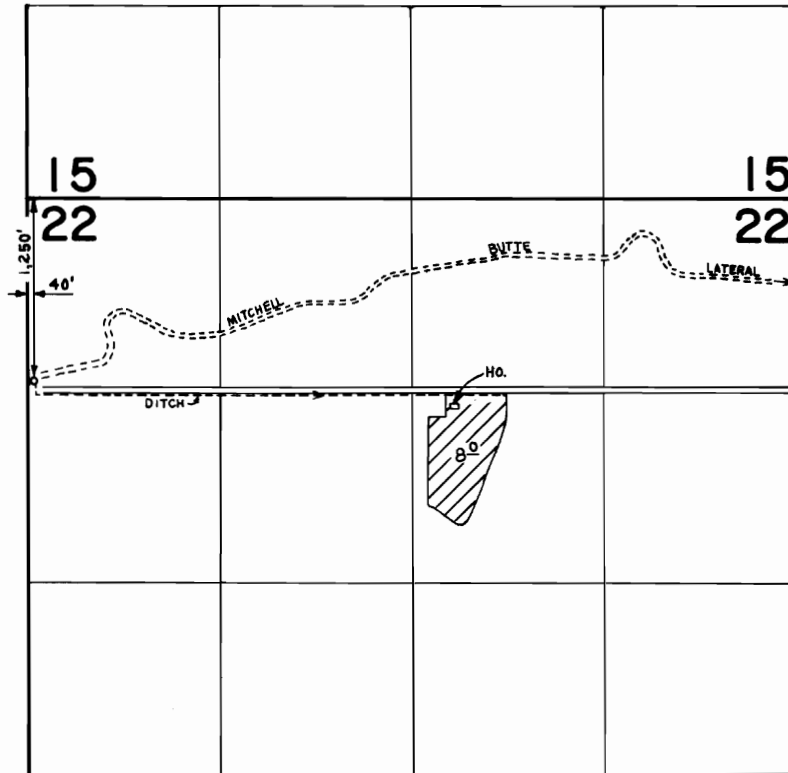

1" = 1,320'

FINAL PROOF SURVEY UNDER

T-4289

Application No. Permit No.
IN NAME OF

HARTLEY, MARK E. & JUNE S.

Surveyed .FEB..27., 1986., by .L.M..TOLL.....