


T. 9 S., R. 14 E., W.M.

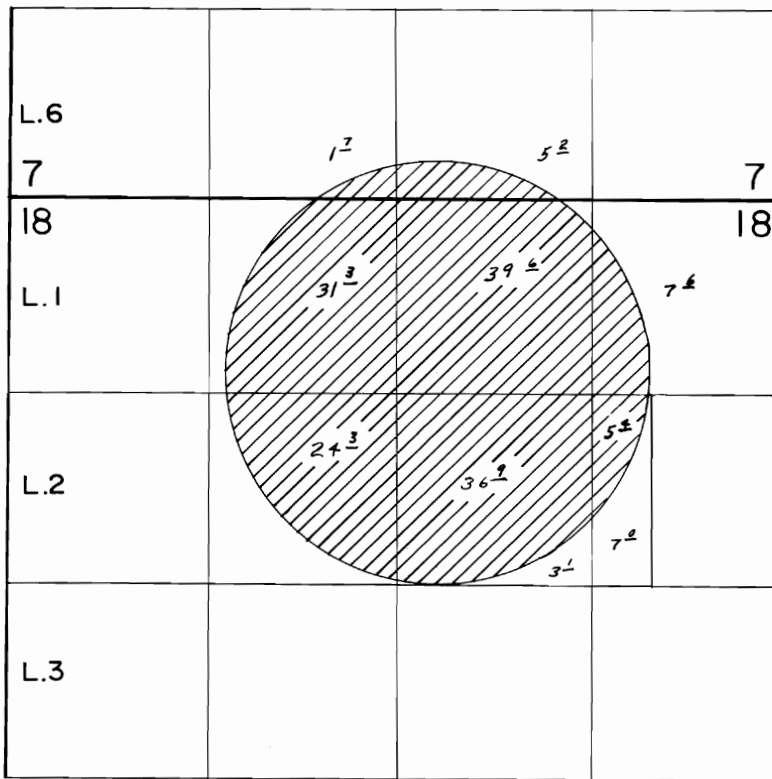

SCALE: 1" = 1320'

FINAL PROOF SURVEY UNDER

TRANSFER T-4299

IN NAME OF

.....RON VIBBERT & SONS, INC.....

Surveyed AUG. 10.. 19.88, by B.BISHOP.....