


T.38 S., R.1 W., W.M.

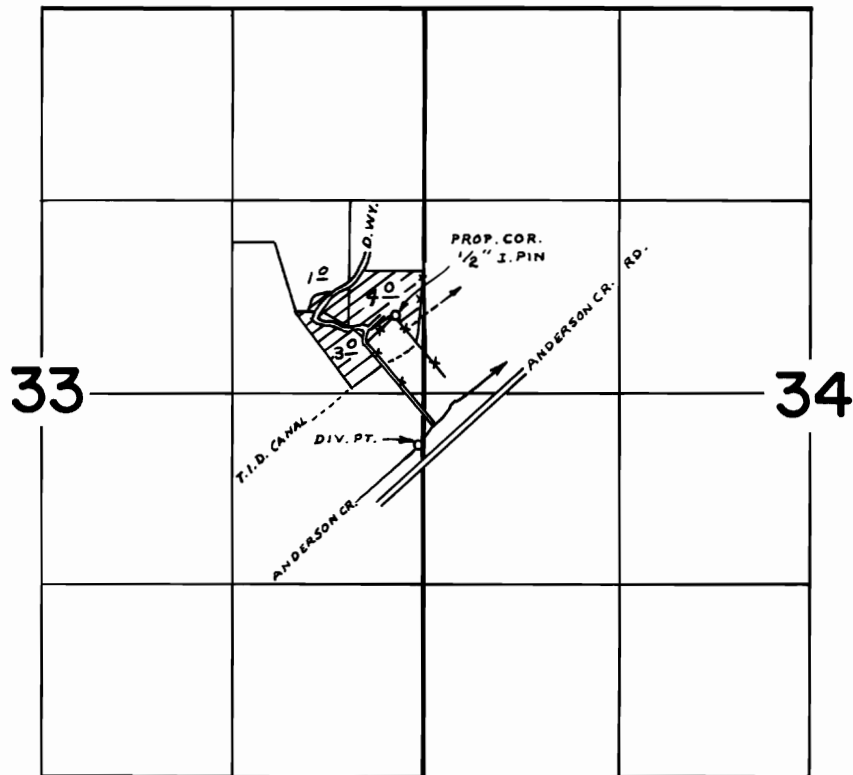

DIV. PT. LOC.: 360' S. & 30' W. FROM E. 1/4 COR. SEC. 33

FINAL PROOF SURVEY

UNDER

T-4306

Transfer No. 3156

Application No. Permit No.

IN NAME OF

MIKLOS & BRENDA M. GYENES

Surveyed SEPT. 28 1978 by B. SUND
AUG. 5, 1981